

need address

STONE
H 2002
5-28-76

MISSISSIPPI
BOARD OF WATER COMMISSIONERS
416 North State Street
130 Jackson, Mississippi 39201

WATER WELL DRILLERS LOG

5-28 date well completed 1976 firm name Stone county well located

LANDOWNER:
Louis Baker

description of formations encountered from to
Top Soil 0 12

(mailing address)

Red clay 12 18

WELL LOCATION:
sec. 9 T. 13 S. R. 20 W.
9 miles S E of (direction) of (nearest town)

Hard sand 18 40

WELL PURPOSE: HOME
(home, irrigation, municipal, industrial)

WELL COMPLETION DATA:

(1) diameter (inches) 2

(2) total depth (feet) 40

(3) static water level (feet) 27 below top of ground

(4) casing (material) Plastic (depth) 35'

(size) if telescope see back.

(5) screen (length) 5' (depth to top) 35'

(size) (material) Plastic

(6) pump (HP) 1 (yield-gpm) 6

(type power) P. Coet

(7) electric log (yes or no) No

(organization running log)

(8) how well bottom plugged
Capped

DRILLERS REMARKS:


RECORDED
INDEXED

JUL 1 1976

MISS. Bd. of Water Comm.

If well telescopes please sketch and show depths.

GROUND LEVEL

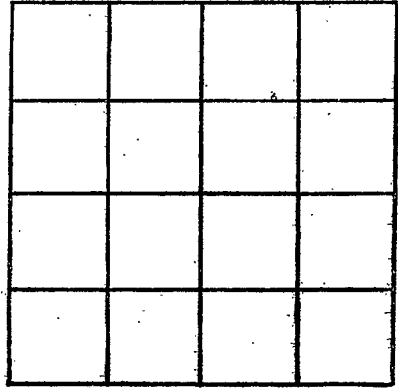

SECTION _____

Please indicate well location X.

ADDITIONAL INFORMATION

If more than one screen, show locations of each on sketch.