

STONE  
H 2003  
8/16/76

MISSISSIPPI  
BOARD OF WATER COMMISSIONERS  
416 North State Street  
132 Jackson, Mississippi 39201

WATER WELL DRILLERS LOG

8-16 1976 Stone Anderson Stone firm name county well located

LANDOWNER:  
Bert Griffin  
(mailing address)  
WELL LOCATION:  
sec. 07 T 03 R 10 E  
07 miles SE of W. 10. 1976  
(distance) (direction) (nearest town)

description of formations encountered	from	to
<u>Top Soil</u>	<u>0</u>	<u>4</u>
<u>white clay</u>	<u>4</u>	<u>28</u>
<u>Coarse Sand</u>	<u>28</u>	<u>45</u>
<u>Clay</u>	<u>45</u>	<u>66</u>
<u>Coarse Sand</u>	<u>66</u>	<u>85</u>

WELL PURPOSE: HOME  
(home, irrigation, municipal, industrial)

WELL COMPLETION DATA:  
(1) diameter (inches) 2"  
(2) total depth (feet) 83'  
(3) static water level (feet) 28' below top of ground  
(4) casing Plastic 80'  
(material) (depth)  
(size) If telescope see back.  
(5) screen 5' 80'  
(length) (depth to top)  
2" Plastic  
(size) (material)  
(6) pump Elect 5'  
(HP) (yield gpm)  
(type power)  
(7) electric log no  
(yes or no)  
(organization running log)  
(8) how well bottom plugged  
Capped


DRILLERS REMARKS:

RECEIVED  
SEP - 7 1976

MISS. BD. OF WATER COMMISSIONERS

If well telescopes please sketch and show depths.

GROUND LEVEL

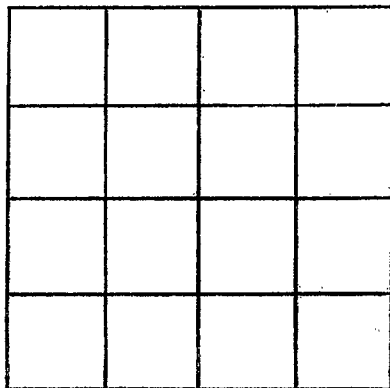

SECTION \_\_\_\_\_

Please indicate well location X.

ADDITIONAL INFORMATION

If more than one screen,  
show locations of each on sketch.