

Stone  
 # 2004  
 8/30/76

MISSISSIPPI  
 BOARD OF WATER COMMISSIONERS  
 416 North State Street  
 Jackson, Mississippi 39201

WATER WELL DRILLERS LOG

8-30 13Q 1976 *Lowell Anderson Stone*  
 date well completed firm name county well located

LANDOWNER:  
*Louis Alexander*  
 (mailing address)

WELL LOCATION:  
 sec. 9 T 3 N R 9 W  
17 miles SE of Wiggins  
 (distance) (direction) (nearest town)

WELL PURPOSE: HOME  
 (home, irrigation, municipal, industrial)

WELL COMPLETION DATA:

(1) diameter (inches) 2"  
 (2) total depth (feet) 305'  
 (3) static water level (feet) 38 below top of ground.  
 (4) casing Plastic, 300'  
 (material) (depth)  
 (size) If telescope see back.  
 (5) screen 5' 300'  
 (length) (depth to top)  
2" Plastic  
 (size) (material)  
 (6) pump 1 2  
 (HP) (yield gpm)  
Elect  
 (type power)  
 (7) electric log no  
 (yes or no)  
 (organization running log)  
 (8) how well bottom plugged Backhoe Valve


description of formations encountered	from	to
Top Soil	0	4
Red Clay	4	10
Coarse Sand	10	44
Blue Clay	44	296
Fine Sand	296	305

RECEIVED  
 SEP 7 1976  
 MISS. BD. OF WATER COMMISSIONERS

DRILLERS REMARKS:

If well telescopes please sketch and show depths.

GROUND LEVEL

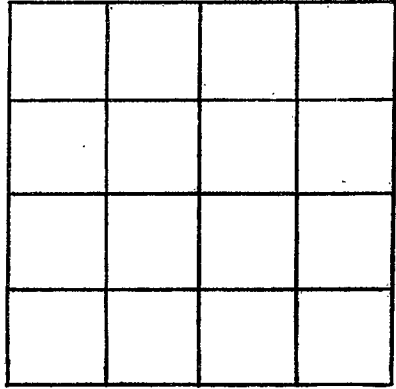

SECTION \_\_\_\_\_

Please indicate well location X.

ADDITIONAL INFORMATION

If more than one screen, show locations of each on sketch.