

Stone
H 2005
9-1-76

MISSISSIPPI
BOARD OF WATER COMMISSIONERS
416 North State Street
Jackson, Mississippi 39201

13a

WATER WELL DRILLERS LOG

9-1 1976 Gene Anderson Stone
date well completed firm name county well located


LANDOWNER:	description of formations encountered	from	to
Roy Hunt (mailing address)	Top soil	0	3
WELL LOCATION: sec. <u>5</u> T <u>3</u> N R <u>9</u> E S W <u>14</u> miles <u>SE</u> of <u>Wiggins</u> (distance) (direction) (nearest town)	Sandy clay	3	18
WELL PURPOSE: <u>HOME</u> (home, irrigation, municipal, industrial)	Coarse sand	18	25
WELL COMPLETION DATA: (1) diameter (inches) <u>2"</u> (2) total depth (feet) <u>25'</u> (3) static water level (feet) <u>17'</u> below above top of ground. (4) casing <u>Plastic, 20'</u> (material) (depth) (size) If telescope see back. (5) screen <u>5'</u> <u>2.0'</u> (length) (depth to top) <u>2"</u> <u>Plastic</u> (size) (material) (6) pump <u>2</u> <u>8</u> (HP) (yield gpm) <u>E. Oct</u> (type power) (7) electric log <u>no</u> (yes or no) (organization running log) (8) how well bottom plugged <u>Chipped</u>			
DRILLERS REMARKS:			

RECEIVED
OCT - 8 1976

MISS. Bd. OF WATER COMMISSIONERS

If well telescopes please sketch and show depths.

GROUND LEVEL

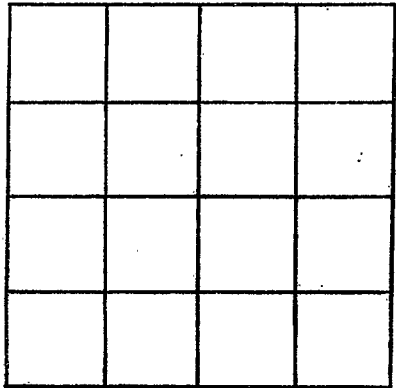

SECTION _____

Please indicate well location X.

ADDITIONAL INFORMATION

If more than one screen, show locations of each on sketch.