

STONE  
 H 2008  
 5-2-77

MISSISSIPPI  
 BOARD OF WATER COMMISSIONERS  
 416 North State Street  
 130 Jackson, Mississippi 39201

WATER WELL DRILLERS LOG

5-2 1977 Permeo Anderson Stone  
 date well completed firm name county well located

LANDOWNER: Stanley Cain  
 (mailing address)

description of formations encountered

description of formations encountered	from	to
Top Soil	0	3
Clay	3	11/2
Coarse Sand	11/2	12 1/2

WELL LOCATION:  
 sec. 7 T. 3 S. R. 9 W.  
12 miles SE of Yalobusha  
 (distance) (direction) (nearest town)

WELL PURPOSE: HOME  
 (home, irrigation, municipal, industrial)

WELL COMPLETION DATA:

(1) diameter (inches) 2"

(2) total depth (feet) 125'

(3) static water level (feet) 61' below top of ground.

(4) casing Plastic, 120'  
 (material) (depth)  
 (size) If telescope see back.

(5) screen 5', 120'  
 (length) (depth to top)  
2" (size) Plastic (material)

(6) pump 1 (HP) 8 (yield gpm)  
Elect (type power)

(7) electric log no (yes or no)  
 (organization running log)

(8) how well bottom plugged capped


RECEIVED  
 JUL 13 1977

DRILLERS REMARKS:

MISS. BD. OF WATER COMMISSIONERS

If well telescopes please sketch and show depths.

GROUND LEVEL

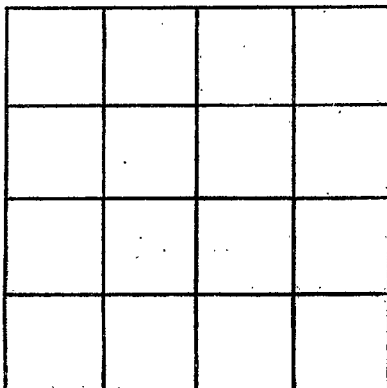

SECTION \_\_\_\_\_

Please indicate well location X.

ADDITIONAL INFORMATION

If more than one screen,  
show locations of each on sketch.