

Stone
 H 200
 6-29-77

MISSISSIPPI
 BOARD OF WATER COMMISSIONERS
 416 North State Street
 132 Jackson, Mississippi 39201

WATER WELL DRILLERS LOG

6-29 1977 Personnel Industries Stone
 date well completed firm name county well located

LANDOWNER:
George Dumall
 (mailing address)

description of formations encountered	from	to
Top Soil	0	2
Clay	2	8
Coarse Sand	8	24
Clay	24	52
Coarse Sand	52	64

WELL LOCATION:
 sec. 10 T. 3 N. R. 10 E.
 S. W.
10 miles SE of Wiggins
 (distance) (direction) (nearest town)

WELL PURPOSE: HOME
 (home, irrigation, municipal, industrial)

WELL COMPLETION DATA:

(1) diameter (inches) 6 1/2"

(2) total depth (feet) 64'

(3) static water level (feet) 22' below above top of ground.

(4) casing Plastic 59'
 (material) (depth)
 (size) if telescope see back.

(5) screen 5' 59'
 (length) (depth to top)
2" Plastic
 (size) (material)

(6) pump 1 10
 (HP) (yield gpm)
Elect
 (type power)

(7) electric log no
 (yes or no)

(organization running log)


(8) how well bottom plugged Capred

DRILLERS REMARKS:

RECEIVED
 JUL 5 1977

If well telescopes please sketch and show depths.

GROUND LEVEL

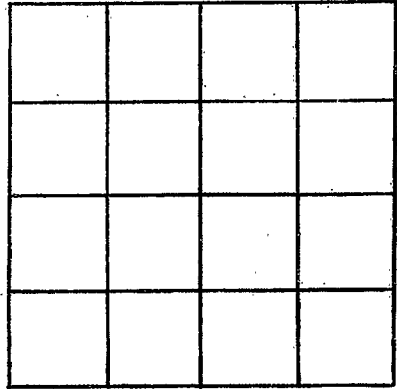

SECTION _____

Please indicate well location X.

ADDITIONAL INFORMATION

If more than one screen, show locations of each on sketch.