

STONE  
H 2010  
7/16/77

MISSISSIPPI  
BOARD OF WATER COMMISSIONERS  
416 North State Street  
130 Jackson, Mississippi 39201

WATER WELL DRILLERS LOG

JULY 16 1977 J. B. WELL CO. STONE  
date well completed firm name county well located

LANDOWNER: LEO WALKER  
RAMSEY SPRINGS  
RK  
(mailing address)

WELL LOCATION:  
sec 3 T 3 N R 9 E  
1.5 miles S DEER CAMP  
(distance) (direction) (nearest town)

WELL PURPOSE:  
(home, irrigation, municipal, industrial)

- WELL COMPLETION DATA:
- (1) diameter (inches) 2
  - (2) total depth (feet) 64
  - (3) static water level (feet) 29 below above top of ground.
  - (4) casing PLASTIC 59 (material) (depth) (size) If telescope see back.
  - (5) screen 6 59 (length) (depth to top) 2" PLASTIC (size) (material)
  - (6) pump 1/2 HP 6 1/2 (HP) (yield gpm) ELEC (type power)
  - (7) electric log (yes or no)
  - (organization running log)
  - (8) how well bottom plugged CAPPED

DRILLERS REMARKS:


description of formations encountered	from	to
TOP SOIL	0	10
SAND	10	20
SAND	20	30
CLAY	30	31
SAND	31	40
SAND	40	50
SAND	50	60
SAND	60	64
CLAY	64	

RECEIVED  
JUL 25 1977

MISS. Bd. OF WATER COMM.

If well telescopes please sketch and show depths.

GROUND LEVEL

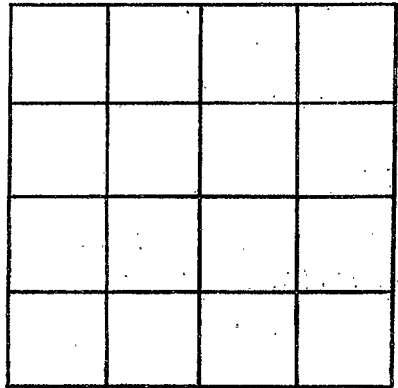

SECTION \_\_\_\_\_

Please indicate well location X.

ADDITIONAL INFORMATION

If more than one screen, show locations of each on sketch.