

Stone
H 20W
8-29-77

MISSISSIPPI
BOARD OF WATER COMMISSIONERS
416 North State Street
Jackson, Mississippi 39201

WATER WELL DRILLERS LOG

8-29 1977
date well completed

firm name

county well located

132
Parne Anderson Stone


LANDOWNER:	description of formations encountered	from	to
Bob Redman	Top Soil	0	3
(mailing address)	Fine Sand	3	20
WELL LOCATION:	Red Clay	20	35
sec 10 T 3 S R 10 E W	Coarse Sand	35	85
10 miles E of Perk			
(distance) (direction) (nearest town)			
WELL PURPOSE: HOME			
(home, irrigation, municipal, industrial)			
WELL COMPLETION DATA:			
(1) diameter (inches) 2"			
(2) total depth (feet) 88'			
(3) static water level (feet) 28' below top of ground			
(4) casing Plastic, 80' (material) (depth)			
(size) If telescope see back.			
(5) screen 5' 80' (length) (depth to top)			
2" Plastic (size) (material)			
(6) pump 1 (HP) 12 (yield gpm)			
Elect (type power)			
(7) electric log No (yes or no)			
(organization running log)			
(8) how well bottom plugged capped			
DRILLERS REMARKS:			

RECEIVED
SEP 28 1977

MISS. BD. OF WATER COMMISSIONERS

If well telescopes please sketch and show depths.

GROUND LEVEL

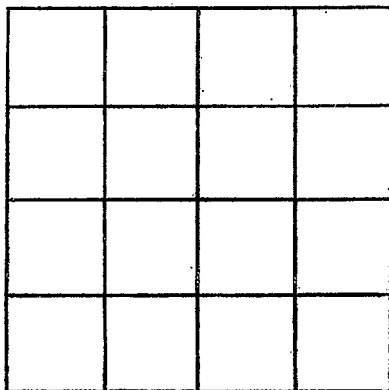

SECTION _____

Please indicate well location X.

ADDITIONAL INFORMATION

If more than one screen, show locations of each on sketch.