

STONE
H <i>2012</i>
<i>4-4-78</i>

**MISSISSIPPI
BOARD OF WATER COMMISSIONERS**
416 North State Street
Jackson, Mississippi 39201

WATER WELL DRILLERS LOG

4-4 19*78* *Carroll Anderson* *Stone*
 date well completed firm name county well located

LANDOWNER:
Esco Bond
 Esco W Bond
 (mailing address)

WELL LOCATION:
 sec. *8* T. *3* N. R. *10* E. W.
9 miles *SE* of *Wiggins*
 (distance) (direction) (nearest town)

WELL PURPOSE: *HOME*
 (home, irrigation, municipal, industrial)

WELL COMPLETION DATA:

(1) diameter (inches) *2"*

(2) total depth (feet) *70'*

(3) static water level (feet) *48'* below above top of ground.

(4) casing *Plastic 65'*
 (material) (depth)

_____ if telescope see back.
 (size)

(5) screen *5'* *65'*
 (length) (depth to top)

2" *Plastic*
 (size) (material)

(6) pump *1* *9*
 (HP) (yield gpm)

Elect
 (type power)

(7) electric log *No*
 (yes or no)

_____ (organization running log)

(8) how well bottom plugged *Capped*


description of formations encountered	from	to
<i>Top Soil</i>	<i>0</i>	<i>2</i>
<i>Clay</i>	<i>2</i>	<i>7</i>
<i>Sand</i>	<i>7</i>	<i>15</i>
<i>Clay</i>	<i>15</i>	<i>32</i>
<i>Course Sand</i>	<i>32</i>	<i>70</i>

DRILLERS REMARKS:

RECEIVED
 MAY 8 - 1978
 MISS. BD. OF WATER COMMISSIONERS

If well telescopes please sketch and show depths.

GROUND LEVEL

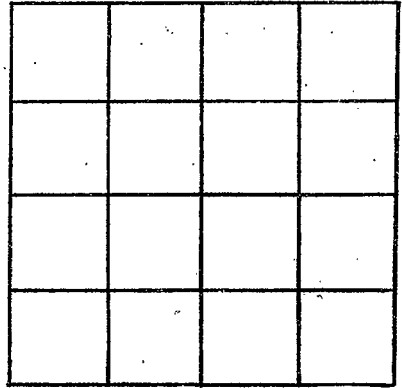

SECTION _____

Please indicate well location X.

ADDITIONAL INFORMATION

If more than one screen,
show locations of each on sketch.