

STONE
 H 2015
 6/28/78

MISSISSIPPI
 BOARD OF WATER COMMISSIONERS
 416 North State Street
 Jackson, Mississippi 39201

WATER WELL DRILLERS LOG

6-28-1978 date well completed
 The Crown Farm Water Co. firm name
 Stone county well located

LANDOWNER: H. Ray Wilson
910 Spanish Acres
Bay St. Louis, MS.
 (mailing address)

description of formations encountered	from	to
18" top soil	0	18"
Red sand	18"	6 1/2'
Sand + Gravel	6 1/2'	20'
Medium	20'	30"
Coarse w/sand	30	43'

WELL LOCATION:
 sec. 18 T. 3 N. R. 10 E. S. 3
7 miles W of Perkins
 (distance) (direction) (nearest town)

WELL PURPOSE:
 (home, irrigation, municipal, industrial)

- WELL COMPLETION DATA:
- diameter (inches) 2"
 - total depth (feet) 45'
 - static water level (feet) 30' below top of ground.
 - casing PVC (material), 45' (depth)
 if telescope see back.
 (size)
 - screen 10' (length), 35' (depth to top)
2" (size), PVC (material)
 - pump 1 (HP), 9 (yield gpm)
220 AC (type power)
 - electric log N/A (yes or no)
 (organization running log)
 - how well bottom plugged —

RECEIVED


JUL 10 1978

DRILLERS REMARKS:
gal well

MISS. BD. OF WATER COMM

If well telescopes please sketch and show depths.

GROUND LEVEL

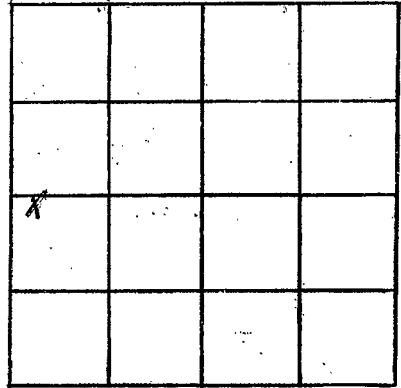

SECTION _____

Please indicate well location X.

ADDITIONAL INFORMATION

*This is an old
well producing
4 gal per min
at air comp rate
28 pound pressure*

If more than one screen,
show locations of each on sketch.