

STONE
H 2007
9-28-78

**MISSISSIPPI
BOARD OF WATER COMMISSIONERS**
416 North State Street
Jackson, Mississippi 39201

WATER WELL DRILLERS LOG

9-28-78 1978 Pennell Anderson Stone
 date well completed firm name county well located

LANDOWNER:
Harbel Sellers

(mailing address)

description of formations encountered	from	to
<u>Top Soil</u>	<u>0</u>	<u>2</u>
<u>Red Clay</u>	<u>2</u>	<u>24</u>
<u>Finl Sand</u>	<u>24</u>	<u>110</u>
<u>Course Sand</u>	<u>110</u>	<u>125</u>

WELL LOCATION:
 sec. 36 T. 3 R. 10
13 miles SE of Park
 (distance) (direction) (nearest town)

WELL PURPOSE: HOME
 (home, irrigation, municipal, industrial)

WELL COMPLETION DATA:

(1) diameter (inches) 2"

(2) total depth (feet) 125'

(3) static water level (feet) 43' below top of ground.

(4) casing Plastic, 120'
 (material) (depth)
 (size) if telescope see back.


(5) screen 5', 120'
 (length) (depth to top)
2", Plastic
 (size) (material).

(6) pump 1, 12
 (HP) (yield gpm)
Elect
 (type power)

(7) electric log no
 (yes or no)

(organization running log)

(8) how well bottom plugged Capped

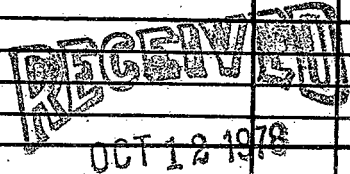


MISS. BD. OF WATER COMMISSIONERS

DRILLERS REMARKS:

If well telescopes please sketch and show depths.

GROUND LEVEL

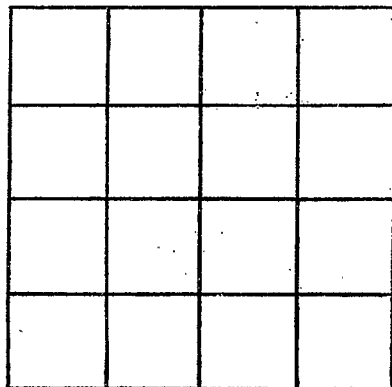

SECTION _____

Please indicate well location X.

ADDITIONAL INFORMATION

If more than one screen,
show locations of each on sketch.