

Stone
 H 2018
 12-26-78

MISSISSIPPI
 BOARD OF WATER COMMISSIONERS
 416 North State Street
 Jackson, Mississippi 39201

WATER WELL DRILLERS LOG

12-26-1978 date well completed
 78 Coast Water Well Serv. firm name
 Stone county well located

LANDOWNER: H. R. Whittington
Rt 1 - Box 145-1
De Kalb County, Miss.
 (mailing address) 37573

description of formations encountered	from	to
Top soil	0	3
Blue Clay	3	16
Sand (C)	16	40
Blue Clay	40	285
Sand (M)	285	318

WELL LOCATION:
 sec. 9 T. 3 S. R. 9 W.
14 miles S. East of Wiggins
 (distance) (direction) (nearest town)


WELL PURPOSE: Home
 (home, irrigation, municipal, industrial)

- WELL COMPLETION DATA:
- (1) diameter (inches) 2"
 - (2) total depth (feet) 318'
 - (3) static water level (feet) 65' below top of ground.
 - (4) casing PVC, 308'
 (material) (depth)
2" if telescope see back.
 (size)
 - (5) screen 10', 308'
 (length) (depth to top)
2", PVC
 (size) (material)
 - (6) pump 1 hp., 8 gal.
 (HP) (yield gpm)
Electric
 (type power)
 - (7) electric log No
 (yes or no)
- (organization running log)
- (8) how well bottom plugged:
Back wash. Value

DRILLERS REMARKS:

If well telescopes please sketch and show depths.

GROUND LEVEL

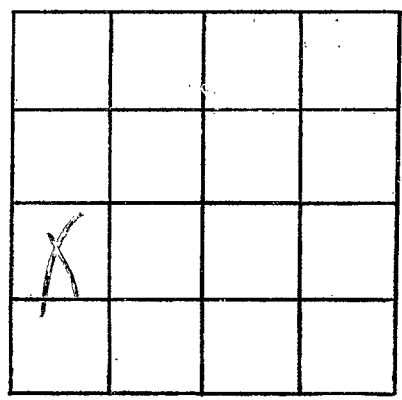

SECTION 2

Please indicate well location X.

ADDITIONAL INFORMATION

Lined area for additional information.

If more than one screen, show locations of each on sketch.