

STONE
H 209
1-18-79

**MISSISSIPPI
BOARD OF WATER COMMISSIONERS**
416 North State Street
Jackson, Mississippi 39201

WATER WELL DRILLERS LOG

1-18 1979 Carroll & Williamson Stone
 date well completed firm name county well located

LANDOWNER:
L. W. Braswell
 (mailing address)

description of formations encountered	from	to
	Top Soil	0
Clay	2	45
Coarse Sand	45	105

WELL LOCATION:
 sec. 7 T. 3 R. 10
7 miles E of Park
 (distance) (direction) (nearest town)

WELL PURPOSE: HOME
 (home, irrigation, municipal, industrial)

WELL COMPLETION DATA:

(1) diameter (inches) 2"

(2) total depth (feet) 105'

(3) static water level (feet) 28' below above top of ground.

(4) casing Plastic, 100'
 (material) (depth)

_____ if telescope see back.
 (size)

(5) screen 5", 100'
 (length) (depth to top)

2", Plastic
 (size) (material)

(6) pump 1, 12
 (HP) (yield gpm)

Electric
 (type power)

(7) electric log no
 (yes or no)

_____ (organization running log)

(8) how well bottom plugged Capped


DRILLERS REMARKS:

RECEIVED

FEB - 2 - 79

If well telescopes please sketch and show depths.

GROUND LEVEL

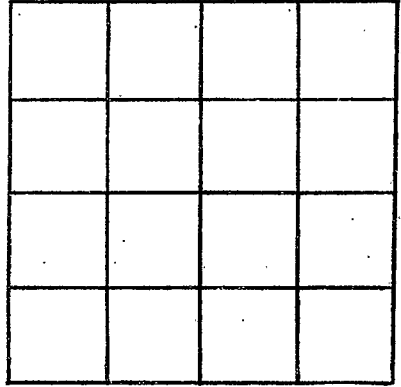

SECTION _____

Please indicate well location X.

ADDITIONAL INFORMATION

If more than one screen,
show locations of each on sketch.