

Stone
H 2020
4-24-79

MISSISSIPPI
BOARD OF WATER COMMISSIONERS
416 North State Street
Jackson, Mississippi 39201

WATER WELL DRILLERS LOG

April 24 1979 *Shannon Well Drilling* Stone
date well completed firm name county well located

LANDOWNER: *S. D. Nelson*
9525 Comstock Ave.
Ocean Springs, Mo.
(mailing address)

description of formations encountered	from	to
<i>TOP Clay</i>	<i>0</i>	<i>50</i>
<i>Shud</i>	<i>50</i>	<i>80</i>
<i>White Clay</i>	<i>80</i>	<i>120</i>
<i>Blue Clay</i>	<i>120</i>	<i>250</i>
<i>Fine Sand</i>	<i>250</i>	<i>280</i>
<i>Course Sand</i>	<i>280</i>	<i>340</i>

WELL LOCATION:
sec *33* T. *3* N. R. *10* E.
15 miles *S.E.* of *White Springs*
(distance) (direction) (nearest town)

WELL PURPOSE: *Home*
(home, irrigation, municipal, industrial)

- WELL COMPLETION DATA:
- (1) diameter (inches) *2"*
 - (2) total depth (feet) *340*
 - (3) static water level (feet) *70* below above top of ground.
 - (4) casing *PVC*, *8.30*,
(material) (depth)
If telescope see back.
(size)
 - (5) screen *10'*, *8.30*
(length) (depth to top)
2", *PVC*
(size) (material)
 - (6) pump *1* *7*
(HP) (yield gpm)
electric
(type power)
 - (7) electric log _____
(yes or no)

(organization running log)

(8) how well bottom plugged *Shud*
Shud

DRILLERS REMARKS:


Miss. Board of Water Comm.

JUN - 5 1979

RECEIVED

If well telescopes please sketch and show depths.

GROUND LEVEL

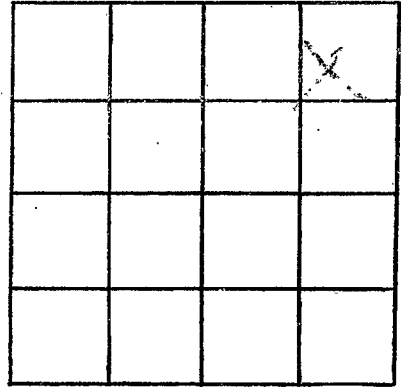

SECTION 33

Please indicate well location X.

ADDITIONAL INFORMATION

If more than one screen,
show locations of each on sketch.