

Stone  
H 2001  
9-25-79

MISSISSIPPI  
BOARD OF WATER COMMISSIONERS  
416 North State Street  
Jackson, Mississippi 39201

WATER WELL DRILLERS LOG


9-25-79 date well completed  
1979 Parnell Anderson firm name  
Stone county well located

LANDOWNER:	description of formations encountered	from	to
Mack Baggett	Top Soil	0	2
(mailing address)	Blue Clay	2	125
<p>WELL LOCATION:</p> <p>sec 26 T 3 S R 9 E</p> <p>14 miles E of Perk</p> <p>(distance) (direction) (nearest town)</p>	Course Sand	125	139
<p>WELL PURPOSE: HOME</p> <p>(home, irrigation, municipal, industrial)</p>			
<p>WELL COMPLETION DATA:</p> <p>(1) diameter (inches) 3"</p> <p>(2) total depth (feet) 139'</p> <p>(3) static water level (feet) 19' below top of ground</p> <p>(4) casing Plastic, 134' (material) (depth)</p> <p>(size) If telescope see back.</p> <p>(5) screen 5' 134' (length) (depth to top)</p> <p>2" Plastic (size) (material)</p> <p>(6) pump 1 13 (HP) (yield gpm)</p> <p>Elect (type power)</p> <p>(7) electric log no (yes or no)</p> <p>(organization running log)</p> <p>(8) how well bottom plugged Capped</p>			
<p>DRILLERS REMARKS:</p>			

rec'd 10-1-79  
[Signature]

If well telescopes please sketch and show depths.

GROUND LEVEL

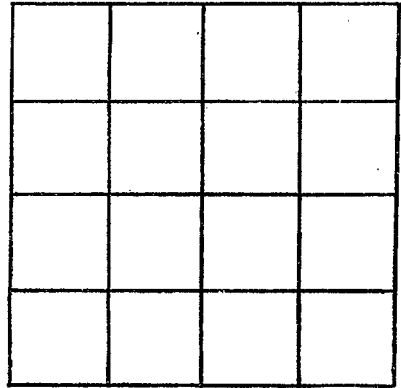

SECTION \_\_\_\_\_

Please indicate well location X.

ADDITIONAL INFORMATION

If more than one screen, show locations of each on sketch.