

Stone  
H 2022  
9-28-79  
9-28

MISSISSIPPI  
 BOARD OF WATER COMMISSIONERS  
 416 North State Street  
 Jackson, Mississippi 39201

WATER WELL DRILLERS LOG

date well completed

firm name

county well located


1979 Parrell Anderson Stone

LANDOWNER:	description of formations encountered	from	to
<u>Lottie Batten</u>	<u>Top Soil</u>	<u>0</u>	<u>3</u>
(mailing address)	<u>Gravel Sand</u>	<u>3</u>	<u>28</u>
WELL LOCATION:	<u>Blue Clay</u>	<u>28</u>	<u>95</u>
sec. <u>7</u> T. <u>3</u> R. <u>2</u>	<u>Gravel Sand</u>	<u>95</u>	<u>102</u>
<u>15</u> miles <u>E</u> of <u>Waveland</u>	<u>Blue Clay</u>	<u>102</u>	<u>133</u>
(distance) (direction) (nearest town)	<u>Coarse Sand</u>	<u>133</u>	<u>171</u>
WELL PURPOSE: <u>HOME</u> (home, irrigation, municipal, industrial)			
WELL COMPLETION DATA:			
(1) diameter (inches) <u>2"</u>			
(2) total depth (feet) <u>171'</u>			
(3) static water level (feet) <u>68</u> below top of ground.			
(4) casing <u>Plastic 166'</u> (material) (depth)			
_____ if telescope see back. (size)			
(5) screen <u>5"</u> <u>166'</u> (length) (depth to top)			
<u>2"</u> <u>Plastic</u> (size) (material)			
(6) pump <u>1</u> <u>9</u> (HP) (yield gpm)			
<u>Elect</u> (type power)			
(7) electric log <u>no</u> (yes or no)			
_____ (organization running log)			
(8) how well bottom plugged <u>Capped</u>			
DRILLERS REMARKS:			

Piedmont 10-1-79

If well telescopes please sketch and show depths.

GROUND LEVEL

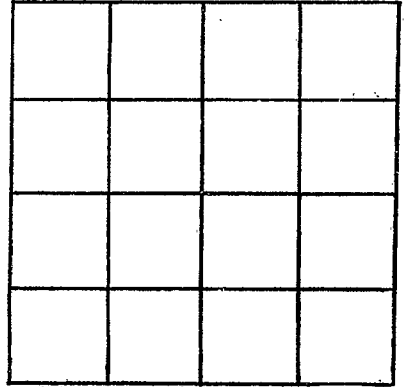

SECTION \_\_\_\_\_

Please indicate well location X.

ADDITIONAL INFORMATION

If more than one screen,  
show locations of each on sketch.