

Stone  
 H 2024  
 11-7-79

MISSISSIPPI  
 BOARD OF WATER COMMISSIONERS  
 416 North State Street  
 Jackson, Mississippi 39201

WATER WELL DRILLERS LOG

11-7 1979 Pernell Anderson Stone  
 date well completed firm name county well located

LANDOWNER:	description of formations encountered	from	to
<u>Burt Fortines</u>	<u>Top Soil</u>	<u>0</u>	<u>3</u>
(mailing address)	<u>Fluv. Sand</u>	<u>3</u>	<u>80</u>
WELL LOCATION:	<u>Course Sand</u>	<u>80</u>	<u>104</u>
sec. <u>7</u> T. <u>3</u> N. R. <u>10</u> E			
<u>6</u> miles <u>E</u> of <u>Perk</u>			
(distance) (direction) (nearest town)			
WELL PURPOSE: <u>HOME</u>			
(home, irrigation, municipal, industrial)			
WELL COMPLETION DATA:			
(1) diameter (inches) <u>2"</u>			
(2) total depth (feet) <u>104'</u>			
(3) static water level (feet) <u>15'</u> below above top of ground.			
(4) casing <u>Plastic</u> , <u>99'</u>			
(material) (depth)			
(size) if telescope see back.			
(5) screen <u>5"</u> , <u>99'</u>			
(length) (depth to top)			
<u>2"</u> , <u>Plastic</u>			
(size) (material)			
(6) pump <u>1</u> , <u>12</u>			
(HP) (yield gpm)			
<u>Elect.</u>			
(type power)			
(7) electric log <u>no</u>			
(yes or no)			
(organization running log)			
(8) how well bottom plugged <u>Capped</u>			
DRILLERS REMARKS:			


DEPT. OF NATURAL RESOURCES  
 BUREAU OF LAND & WATER RESOURCES

DEC 10 1979

RECEIVED

If well telescopes please sketch and show depths.

GROUND LEVEL

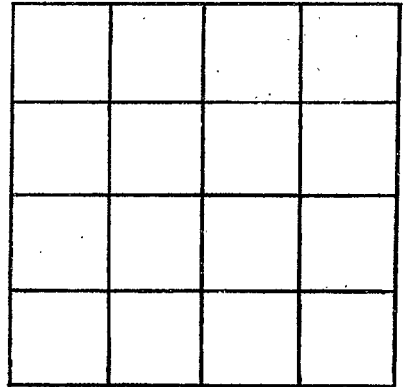

SECTION \_\_\_\_\_

Please indicate well location X.

ADDITIONAL INFORMATION

If more than one screen,  
show locations of each on sketch.