

Stone
H 2025
10-12-79

MISSISSIPPI
BOARD OF WATER COMMISSIONERS
416 North State Street
Jackson, Mississippi 39201

WATER WELL DRILLERS LOG

10-12
date well completed

1979 Bernell Anderson
firm name

Stone
county well located

LANDOWNER:
Earl Peltor

(mailing address)

WELL LOCATION:

sec. 17 T. 3 N. R. 10 E.
7 1/2 miles E of Perk
(distance) (direction) (nearest town)

WELL PURPOSE: HOME
(home, irrigation, municipal, industrial)

WELL COMPLETION DATA:

- (1) diameter (inches) 2"
(2) total depth (feet) 81'
(3) static water level (feet) 20' below
top of ground. above
(4) casing Plastic, 76'
(material) (depth)

If telescope see back.
(size)

- (5) screen 5", 76'
(length) (depth to top)
2", Plastic
(size) (material)
(6) pump 1, 20
(HP) (yield gpm)
Elect
(type power)
(7) electric log no
(yes or no)

(organization running log)

- (8) how well bottom plugged Capped

description of formations
encountered

from to

Top Soil

0 3

Clay

3 35

Course Sand

35 81

DEPT. OF NATURAL RESOURCES
BUREAU OF LAND & WATER RESOURCES


NOV 20 1979

RECEIVED

DRILLERS REMARKS:

If well telescopes please sketch and show depths.

GROUND LEVEL

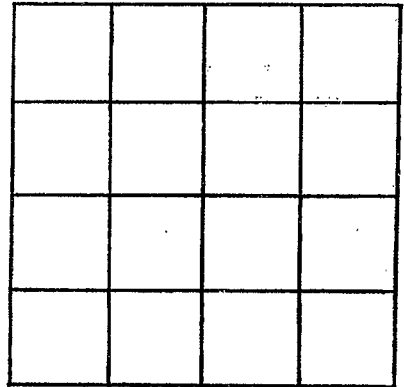

SECTION _____

Please indicate well location X.

ADDITIONAL INFORMATION

If more than one screen,
show locations of each on sketch.