

Stover  
Hoxse  
10-9-77

MISSISSIPPI  
BOARD OF WATER COMMISSIONERS  
416 North State Street  
Jackson, Mississippi 39201

WATER WELL DRILLERS LOG

10-9-77  
date well completed 1977  
Ramel Anderson  
firm name Stone  
county well located

LANDOWNER:	description of formations encountered	from	to
Roderick Oneil	Top Soil	0	2
(mailing address)	Sandy Clay	2	18
WELL LOCATION:	Course Sand	18	28
sec. 14 T. 3 N. R. 10 E			
11 miles E of Perk			
(distance) (direction) (nearest town)			
WELL PURPOSE: HOME			
(home, irrigation, municipal, industrial)			
WELL COMPLETION DATA:			
(1) diameter (inches) 2"			
(2) total depth (feet) 8.5'			
(3) static water level (feet) 22' below top of ground.			
(4) casing Plastic, 80' (material) (depth)			
(size) if telescope see back.			
(5) screen 5' 80' (length) (depth to top)			
2" Plastic (size) (material)			
(6) pump 1 14 (HP) (yield gpm)			
Collect (type power)			
(7) electric log no (yes or no)			
(organization running log)			
(8) how well bottom plugged Capped			
DRILLERS REMARKS:			


DEPT. OF NATURAL RESOURCES  
BUREAU OF LAND & WATER RESOURCES

NOV 20 1979

RECEIVED

If well telescopes please sketch and show depths.

GROUND LEVEL

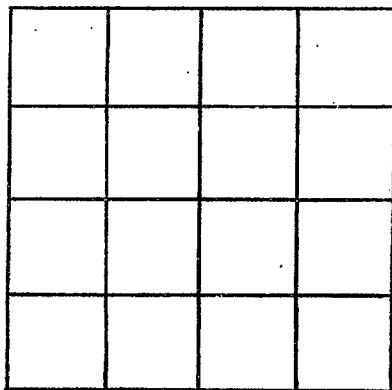

SECTION \_\_\_\_\_

Please indicate well location X.

ADDITIONAL INFORMATION

If more than one screen,  
show locations of each on sketch.