

Stone
H 2027
5-13-80

MISSISSIPPI
BOARD OF WATER COMMISSIONERS
416 North State Street
Jackson, Mississippi 39201

WATER WELL DRILLERS LOG

4-11 1980 Stone Stone
date well completed firm name county well located

LANDOWNER:
Lenise Walker

description of formations encountered
Top Soil from 0 to 2

(mailing address)

Red clay 2 to 15

WELL LOCATION:
sec 33 T 3 N R 9 S
1.5 miles E of Park
(distance) (direction) (nearest town)

Course Sand 15 to 65

WELL PURPOSE: HOME
(home, irrigation, municipal, industrial)

WELL COMPLETION DATA:

- (1) diameter (inches) 2"
- (2) total depth (feet) 65'
- (3) static water level (feet) 50' below above top of ground.
- (4) casing Plastic 60'
(material) (depth)
- _____ if telescope see back.
(size)
- (5) screen 25" 60'
(length) (depth to top)
- 2" Plastic
(size) (material)
- (6) pump 1 11
(HP) (yield gpm)
- Elect
(type power)
- (7) electric log no
(yes or no)
- _____ (organization running log)
- (8) how well bottom plugged Capped

DRILLERS REMARKS:


DEPT. OF NATURAL RESOURCES
BUREAU OF LAND & WATER RESOURCES

MAY 12 1980

RECEIVED

If well telescopes please sketch and show depths.

GROUND LEVEL

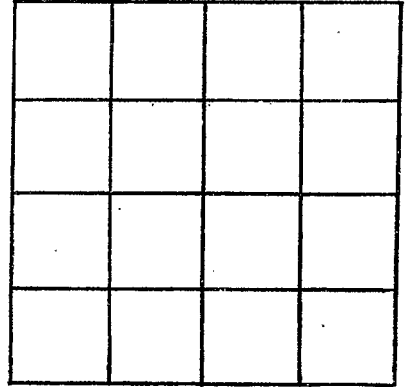

SECTION _____

Please indicate well location X.

ADDITIONAL INFORMATION

If more than one screen,
show locations of each on sketch.