

Stone
H 2018
5-22-80

MISSISSIPPI
BOARD OF WATER COMMISSIONERS
416 North State Street
Jackson, Mississippi 39201

WATER WELL DRILLERS LOG

5-22 date well completed
 Daniel Anderson Stone firm name
 Stone county well located

LANDOWNER:	description of formations encountered	from	to
Tom Bankington	Top Soil	0	2
(mailing address)	fine sand	2	45
WELL LOCATION:	Clay	45	102
sec 5 T 3 N R 10 E	Coarse Sand	102	105
9 miles SE of Wiggins			
(distance) (direction) (nearest town)			
WELL PURPOSE: HOME			
(home, irrigation, municipal, industrial)			
WELL COMPLETION DATA:			
(1) diameter (inches) 2"			
(2) total depth (feet) 125'			
(3) static water level (feet) 77' below top of ground			
(4) casing Plastic 120 (material) (depth)			
(size) If telescope see back.			
(5) screen 5' 120 (length) (depth to top)			
2" Plastic (size) (material)			
(6) pump 1 8 (HP) (yield gpm)			
Elect (type power)			
(7) electric log No (yes or no)			
(organization running log)			
(8) how well bottom plugged Capped			
DRILLERS REMARKS:			


DEPT. OF NATURAL RESOURCES
 BUREAU OF LAND & WATER RESOURCES

JUN 4 - 1980

RECEIVED

If well telescopes please sketch and show depths.

GROUND LEVEL

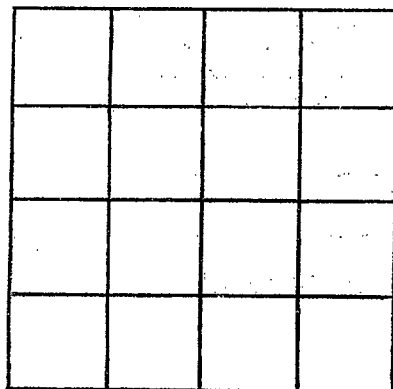

SECTION _____

Please indicate well location X.

ADDITIONAL INFORMATION

If more than one screen,
show locations of each on sketch.