

MISSISSIPPI DEPARTMENT OF NATURAL RESOURCES

Bureau of Land and Water Resources

Southport Mall

P.O. Box 10631

Jackson, Mississippi 39209

WATER WELL DRILLERS LOG **STONE**

STONE
H 2030
8-6-81

8-6-81 date well completed
Coast Water Well Service firm name
Jackson county well located

LANDOWNER: Roy Dunigan
7639 Lexington Dr.
Biloxi, Miss.
(mailing address)


WELL LOCATION:
sec. 21 T 4 N R 9 E
S W
1 1/2 miles SE of PERKINSTON
(distance) (direction) (nearest town)

WELL PURPOSE: Home
(home, irrigation, municipal, industrial)

WELL COMPLETION DATA:

- (1) diameter (inches) 2"
- (2) total depth (feet) 245'
- (3) static water level (feet) 50' below top of ground.
- (4) casing PVC, 235' (material), (depth)
- 2" (size) if telescope see back.
- (5) screen 10' (length), 235' (depth to top)
- 2" (size), PVC (material)
- (6) pump 1 hp (HP), 8 (yield gpm)
- Elect. (type power)
- (7) electric log No - (yes or no)
- (organization running log)
- (8) how well bottom plugged Back Wash Valve


description of formations encountered	from	to
Top Soil	0	5'
Red Clay	5'	18'
Blue Clay	18'	90'
Blue Clay & Streak		
Sand	90'	95'
Blue Clay	95'	190'
Blue fine sand	190'	215'
Gray Coarse Sand	215'	245'

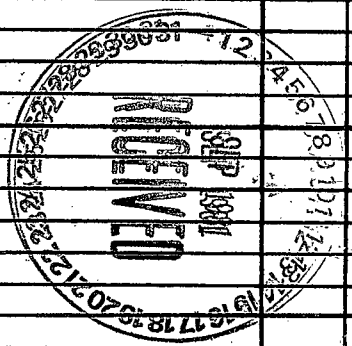

DRILLERS REMARKS:

If well telescopes please sketch and show depths.

GROUND LEVEL

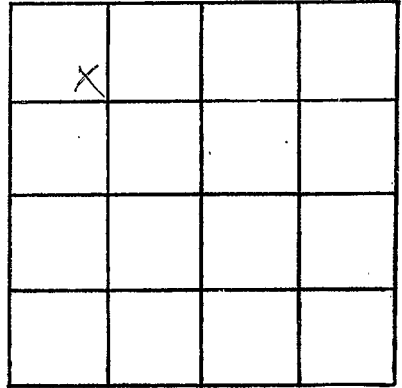

SECTION 21

Please indicate well location X.

ADDITIONAL INFORMATION

If more than one screen, show locations of each on sketch.