

MISSISSIPPI DEPARTMENT OF NATURAL RESOURCES

Bureau of Land and Water Resources

Southport Mall

P.O. Box 10631

Jackson, Mississippi 39209

WATER WELL DRILLERS LOG

Stone
H 2031
9/18/81

9/18/81 19
date well completed

Lyman Well Co.
firm name

Stone
county well located

LANDOWNER: John L. Hunt
Rt. 1, Box 144C
Perkinston, Md
(mailing address)

description of formations encountered

from to

red clay	0	12
sand & gravel	12	28
blue clay	28	140
sand pit	140	170

WELL LOCATION:

sec. 8 T 3 N R 9 E
15 miles SE of Wiggins
(distance) (direction) (nearest town)

WELL PURPOSE: home
(home, irrigation, municipal, industrial)

WELL COMPLETION DATA:

- (1) diameter (inches) 2"
- (2) total depth (feet) 170'
- (3) static water level (feet) 71' below top of ground
- (4) casing PVC 160' (material), (depth)
2" (size) if telescope see back.
- (5) screen 10' 160' (length), (depth to top)
2" PVC (size), (material)
- (6) pump 1 12 (HP), (yield gpm)
electric (type power)
- (7) electric log NO (yes or no)
NO (organization running log)
- (8) how well bottom plugged Sand seal


DRILLERS REMARKS:

DEPT. OF NATURAL RESOURCES
BUREAU OF LAND & WATER RESOURCES

OCT 20 1981
RECEIVED

If well telescopes please sketch and show depths.

GROUND LEVEL

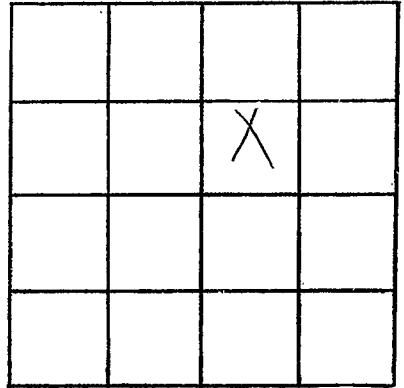

SECTION 8

Please indicate well location X.

ADDITIONAL INFORMATION

If more than one screen,
show locations of each on sketch.