

MISSISSIPPI DEPARTMENT OF NATURAL RESOURCES

Bureau of Land and Water Resources

Southport Mall

P.O. Box 10631

Jackson, Mississippi 39209

WATER WELL DRILLERS LOG

Stone
H 2032
10-8-81


10-8 date well completed 19 81 Frank Pucci firm name Stone county well located

LANDOWNER:	description of formations encountered	from	to
John B Loft	Top Soil	0	3
(mailing address)	Sandy Clay	3	15
WELL LOCATION:	Course Sand	15	82
sec. 17 T. 3 R. 10			
3 miles S.E. of Big Level			
(distance) (direction) (nearest town)			
WELL PURPOSE: HOME			
(home, irrigation, municipal, industrial)			
WELL COMPLETION DATA:			
(1) diameter (inches) 2"			
(2) total depth (feet) 82'			
(3) static water level (feet) 18' below top of ground.			
(4) casing Plastic, 77' (material) (depth)			
(size) If telescope see back.			
(5) screen 5" 77' (length) (depth to top)			
2" Plastic (size) (material)			
(6) pump 1 9 (HP) (yield gpm)			
Elect (type power)			
(7) electric log no (yes or no)			
(organization running log)			
(8) how well bottom plugged capped			
DRILLERS REMARKS:			

DEPT. OF NATURAL RESOURCES
BUREAU OF LAND & WATER RESOURCES
NOV 3 1981
RECEIVED

If well telescopes please sketch and show depths.

GROUND LEVEL

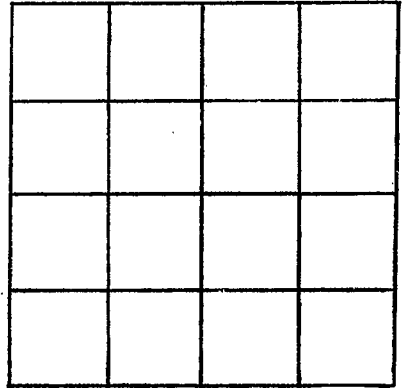

SECTION _____

Please indicate well location X.

ADDITIONAL INFORMATION

If more than one screen,
show locations of each on sketch.