

Stone  
H. 2033

MISSISSIPPI  
 BOARD OF WATER COMMISSIONERS  
 416 North State Street  
 Jackson, Mississippi 39201

WATER WELL DRILLERS LOG

1-6- 1982 James Anderson Stone  
 date well completed firm name county well located

LANDOWNER: James Field

description of formations encountered

from to

P.O. Box

Wiggins Ms 39577  
 (mailing address)

<u>top soil</u>	<u>0</u>	<u>3</u>
<u>sand</u>	<u>3</u>	<u>15</u>
<u>clay</u>	<u>15</u>	<u>34</u>
<u>fine sand</u>	<u>34</u>	<u>48</u>
<u>coarse</u>	<u>48</u>	<u>55</u>

WELL LOCATION:

sec. 5 T B R. 10  
 S W  
12 miles E of Wiggins  
 (distance) (direction) (nearest town)

WELL PURPOSE: name  
 (home, irrigation, municipal, industrial)

WELL COMPLETION DATA:

- (1) diameter (inches) 2"
- (2) total depth (feet) 55'
- (3) static water level (feet) 40 below top of ground.
- (4) casing 2" 50'  
 (material) (depth)
- (size) if telescope see back.
- (5) screen 5' 50'  
 (length) (depth to top)
- 2" PVC  
 (size) (material)
- (6) pump 1 8  
 (HP) (yield gpm)
- Electric  
 (type power)
- (7) electric log NO  
 (yes or no)

DEPT. OF NATURAL RESOURCES  
 BUREAU OF LAND & WATER RESOURCES

MAR 12 1982

RECEIVED

DEPT. OF NATURAL RESOURCES  
 BUREAU OF LAND & WATER RESOURCES

MAR 1982

RECEIVED


(organization running log)

(8) how well bottom plugged Capped

DRILLERS REMARKS:

If well telescopes please sketch and show depths.

GROUND LEVEL

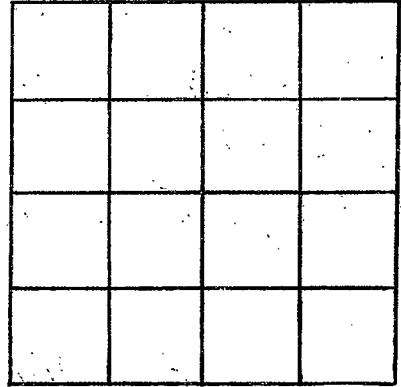

SECTION \_\_\_\_\_

Please indicate well location X.

ADDITIONAL INFORMATION

If more than one screen,  
show locations of each on sketch.