

MISSISSIPPI DEPARTMENT OF NATURAL RESOURCES

Bureau of Land and Water Resources

Southport Mall

P.O. Box 10631

Jackson, Mississippi 39209

WATER WELL DRILLERS LOG

Stone  
H 2034

2-4 1982  
date well completed

Frank Rice  
firm name

Stone  
county well located

LANDOWNER:	description of formations encountered	from	to
<u>Monroe Creal</u>	<u>Top Soil</u>	<u>8</u>	<u>2</u>
(mailing address)	<u>Clay</u>	<u>2</u>	<u>9</u>
WELL LOCATION:	<u>Coarse Sand</u>	<u>9</u>	<u>24</u>
sec. <u>9</u> T. <u>3</u> S. R. <u>10</u> W.			
<u>3</u> miles <u>E</u> of <u>Big Lake</u>			
(distance) (direction) (nearest town)			
WELL PURPOSE: <u>HOME</u>			
(home, irrigation, municipal, industrial)			
WELL COMPLETION DATA:			
(1) diameter (inches) <u>2"</u>			
(2) total depth (feet) <u>27'</u>			
(3) static water level (feet) <u>6'</u> below top of ground.			
(4) casing <u>Plastic</u> , <u>22'</u> (material), (depth)			
(size) if telescope see back.			
(5) screen <u>5'</u> , <u>22'</u> (length), (depth to top)			
<u>2"</u> , <u>Plastic</u> (size), (material)			
(6) pump <u>1</u> (HP), <u>10</u> (yield gpm)			
<u>Elect</u> (type power)			
(7) electric log <u>no</u> (yes or no)			
(organization running log)			
(8) how well bottom plugged <u>Capped</u>			
DRILLERS REMARKS:			


DEPT. OF NATURAL RESOURCES  
BUREAU OF LAND & WATER RESOURCES

MAR 22 1982

RECEIVED

If well telescopes please sketch and show depths.

GROUND LEVEL

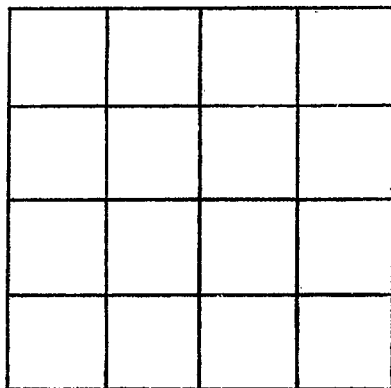

SECTION \_\_\_\_\_

Please indicate well location X.

ADDITIONAL INFORMATION

If more than one screen,  
show locations of each on sketch.