

Stone
H 2035

MISSISSIPPI
 BOARD OF WATER COMMISSIONERS
 416 North State Street
 Jackson, Mississippi 39201

WATER WELL DRILLERS LOG

June 21 1982 Farnell Andersen Stone
 date well completed firm name county well located

LANDOWNER: Stuart Compston
St 3
Perkinston
 (mailing address)

description of formations encountered	from	to
<u>top soil</u>	<u>0</u>	<u>2</u>
<u>clay</u>	<u>2</u>	<u>12</u>
<u>sand</u>	<u>12</u>	<u>40</u>
<u>clay</u>	<u>40</u>	<u>58</u>
<u>sand</u>	<u>58</u>	<u>85</u>

WELL LOCATION:
 sec. 9 T. 3 S. R. 10 E. W. W
13 miles SE of Wiggins
 (distance) (direction) (nearest town)

WELL PURPOSE: Home
 (home, irrigation, municipal, industrial)

- WELL COMPLETION DATA:
- (1) diameter (inches) 2"
 - (2) total depth (feet) 85'
 - (3) static water level (feet) 40' below top of ground.
 - (4) casing P.V.C.
 (material) (depth)
 - _____ if telescope see back.
 (size)
 - (5) screen 5" 80'
 (length) (depth to top)
 - 2" PVC
 (size) (material)
 - (6) pump 1 10
 (HP) (yield gpm)
 - Electric
 (type power)
 - (7) electric log NO
 (yes or no)
 - _____ (organization running log)
 - (8) how well bottom plugged Capped

DRILLERS REMARKS:


DEPT. OF NATURAL RESOURCES
 BUREAU OF LAND & WATER RESOURCES

SEP 21 1982

RECEIVED

If well telescopes please sketch and show depths.

GROUND LEVEL

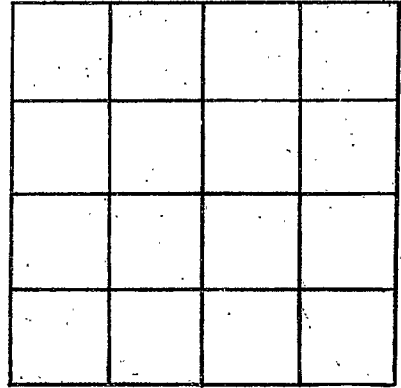

SECTION _____

Please indicate well location X.

ADDITIONAL INFORMATION

If more than one screen, show locations of each on sketch.