

MISSISSIPPI DEPARTMENT OF NATURAL RESOURCES

Bureau of Land and Water Resources

Southport Mall

P.O. Box 10631

Jackson, Mississippi 39209

WATER WELL DRILLERS LOG

Stone
H 2032

1-4 1983 Frank Price Stone
date well completed firm name county well located

LANDOWNER:
Henry Humphrey
(mailing address)

description of formations encountered	from	to
<u>Top Soil</u>	<u>0</u>	<u>3'</u>
<u>Red clay</u>	<u>3</u>	<u>18</u>
<u>Coarse Sand</u>	<u>18</u>	<u>50</u>

WELL LOCATION:
sec 29 T 3 R 9
1 1/2 miles S of Red Creek
(distance) (direction) (nearest town)

WELL PURPOSE: HOME
(home, irrigation, municipal, industrial)

WELL COMPLETION DATA:

(1) diameter (inches) 2 3/8"

(2) total depth (feet) 50'

(3) static water level (feet) 30' below above top of ground.

(4) casing Plastic 45'
(material) (depth)

_____ if telescope see back.
(size)

(5) screen 3" 45'
(length) (depth to tap)

2" Plastic
(size) (material)

(6) pump 1 8
(HP) (yield gpm)

Elect
(type power)

(7) electric log no
(yes or no)

DEPT. OF NATURAL RESOURCES
BUREAU OF LAND & WATER RESOURCES

FEB - 4 1983

RECEIVED


_____ (organization running log)

(8) how well bottom plugged Capped

DRILLERS REMARKS:

If well telescopes please sketch and show depths.

GROUND LEVEL

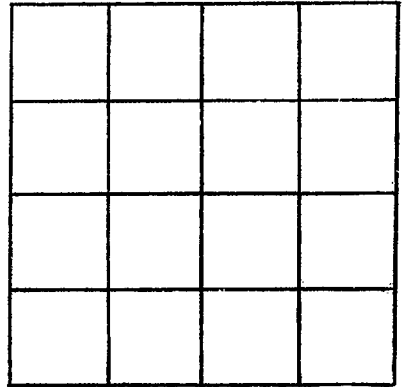

SECTION _____

Please indicate well location X.

ADDITIONAL INFORMATION

If more than one screen,
show locations of each on sketch.