

MISSISSIPPI DEPARTMENT OF NATURAL RESOURCES

Bureau of Land and Water Resources

Southport Mall

P.O. Box 10631

Jackson, Mississippi 39209

WATER WELL DRILLERS LOG

**STONE**  
**H 2038**

7-20 1984  
 date well completed


Frank Pric  
 firm name

Stone  
 county well located

LANDOWNER:	description of formations encountered	from	to
Kent Hatten	Top Soil	0	2
(mailing address)	in solid sand	2	100
WELL LOCATION:	Course Sand	100	109
sec. 6 T 3 S R 10 E W.			
1 1/2 miles E of Big Level			
(distance) (direction) (nearest town)			
WELL PURPOSE: HOME			
(home, irrigation, municipal, industrial)			
WELL COMPLETION DATA:			
(1) diameter (inches) 2"			
(2) total depth (feet) 109'			
(3) static water level (feet) 30' below top of ground.			
(4) casing PVC, 104' (material) (depth)			
(size) If telescope see back.			
(5) screen 5' length, 104' depth to top			
2" PVC (size) (material)			
(6) pump 1 HP, 10 yield gpm			
Elect (type power)			
(7) electric log no (yes or no)			
(organization running log)			
(8) how well bottom plugged			
BWP			
DRILLERS REMARKS:			

If well telescopes please sketch and show depths.

GROUND LEVEL

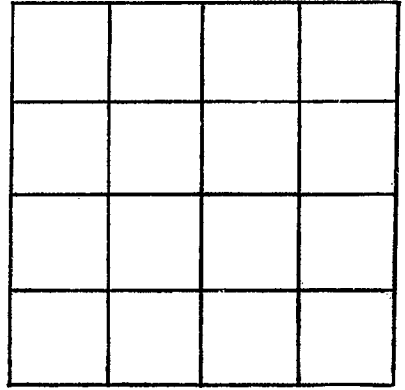

SECTION \_\_\_\_\_

Please indicate well location X.

ADDITIONAL INFORMATION

If more than one screen,  
show locations of each on sketch.