

MISSISSIPPI DEPARTMENT OF NATURAL RESOURCES

Bureau of Land and Water Resources

Southport Mall

P.O. Box 10631

Jackson, Mississippi 39209

WATER WELL DRILLERS LOG

STONE
H2040

11-14
 date well completed

1985- Frank Price
 firm name

Stone
 county well located

LANDOWNER:

Mack Sheffield

(mailing address)

WELL LOCATION:

sec 20 T 3 S R 9 W
Ramsey Springs
 miles of (nearest town)

WELL PURPOSE: HOME
 (home, irrigation, municipal, industrial)

WELL COMPLETION DATA:

- (1) diameter (inches) 2"
- (2) total depth (feet) 110'
- (3) static water level (feet) 40' below above top of ground.
- (4) casing PVC, 100'
 (material) (depth)
2" if telescope see back.
 (size)
- (5) screen 10', 100'
 (length) (depth to top)
2", PVC
 (size) (material)
- (6) pump 1, 6
 (HP) (yield gpm)
Elect
 (type power)
- (7) electric log NO
 (yes or no)

(organization running log)

(8) how well bottom plugged BWV

DRILLERS REMARKS:

description of formations encountered

from to

Top Soil


0 2

Clay

2 80

Line Sand

80 110

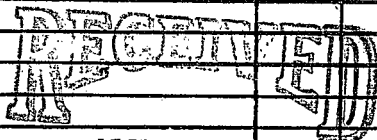


JAN 09 1986

Department of Natural Resources
 Bureau of Land & Water Resources

If well telescopes please
sketch and show depths.

GROUND LEVEL

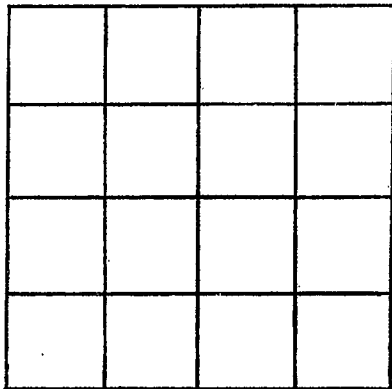

SECTION _____

Please indicate well location X.

ADDITIONAL INFORMATION

If more than one screen,
show locations of each on sketch.