

MISSISSIPPI DEPARTMENT OF NATURAL RESOURCES

Bureau of Land and Water Resources

Southport Mall

P.O. Box 10631

Jackson, Mississippi 39209

WATER WELL DRILLERS LOG

Stone
Haas

8-22 1985 FRANK PRICE STONE
 date well completed firm name county well located

LANDOWNER:	description of formations encountered	from	to
LOUIS SHARP			
(mailing address)	SAND CLAY	2	15
WELL LOCATION:	HARD CLAY	15	100
sec 17 T-3 R-9 S W	COURSE SAND	100	128
1 1/2 miles S RED CREEK			
(distance) (direction) (nearest town)			
WELL PURPOSE: HOME			
(home, irrigation, municipal, industrial)			
WELL COMPLETION DATA:			
(1) diameter (inches) 2"			
(2) total depth (feet) 128'			
(3) static water level (feet) 40' below top of ground.			
(4) casing PCV, 118' (material) (depth)			
(size) if telescope see back.			
(5) screen 10' length, 118' depth to top			
2" size, PCV material			
(6) pump 1 HP, 12 yield gpm			
ELECT (type power)			
(7) electric log NO (yes or no)			
NO (organization running log)			
(8) how well bottom plugged BWV			

RECEIVED


NOV 20 1985

Department of Natural Resources
 Bureau of Land & Water Resources

DRILLERS REMARKS:

If well telescopes please sketch and show depths.

GROUND LEVEL

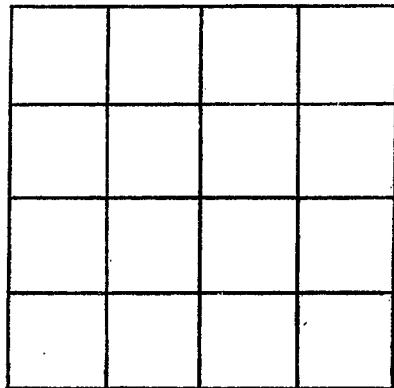

SECTION _____

Please indicate well location X.

ADDITIONAL INFORMATION

If more than one screen, show locations of each on sketch.