

MISSISSIPPI DEPARTMENT OF NATURAL RESOURCES

Bureau of Land and Water Resources

Southport Mall

P.O. Box 10631

Jackson, Mississippi 39209

WATER WELL DRILLERS LOG

STONE
H 2043

10-17 1985 FRANK PRICE STONE
 date well completed firm name county well located

LANDOWNER:	description of formations encountered	from	to
KATHERIN LUKE			
(mailing address)	WITH CLAY	2	50
WELL LOCATION: sec 20 T 3 R 9 RAMSEY SPRINGS	BLUE CLAY	50	100
(distance) miles (direction) of (nearest town)	FINE SAND	100	125
WELL PURPOSE: HOME (home, irrigation, municipal, industrial)	COURSE SAND	125	142
WELL COMPLETION DATA:			
(1) diameter (inches) 2"			
(2) total depth (feet) 142'			
(3) static water level (feet) 30" below top of ground.			
(4) casing PCV, 132' (material) (depth)			
(size) if telescope see back.			
(5) screen 10' 132' (length) (depth to top)			
2" P.V.C. (size) (material)			
(6) pump 1 10 (HP) (yield gpm)			
ELECT (type power)			
(7) electric log NO (yes or no)			
NO (organization running log)			
(8) how well bottom plugged B W V			


RECEIVED
 NOV 19 1985

DRILLERS REMARKS:

Department of Natural Resources
 Bureau of Land & Water Resources

If well telescopes please
sketch and show depths.

GROUND LEVEL

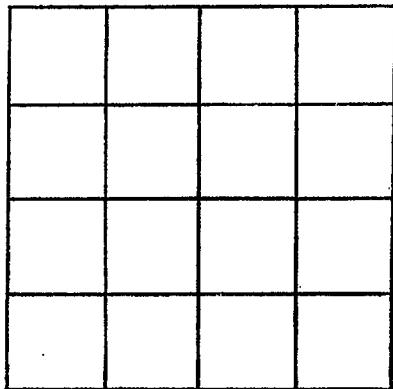

SECTION _____

Please indicate well location X.

ADDITIONAL INFORMATION

If more than one screen,
show locations of each on sketch.