

MISSISSIPPI DEPARTMENT OF NATURAL RESOURCES

Bureau of Land and Water Resources

Southport Mall

P.O. Box 10631

Jackson, Mississippi 39209

WATER WELL DRILLERS LOG

STONE
H 2044

4-28 19 80 Frank Price I tone
date well completed firm name county well located

LANDOWNER:
Darrell Bond

(mailing address)

description of formations encountered	from	to
<u>Top Soil</u>	<u>0</u>	<u>2</u>
<u>Coarse Sand</u>	<u>2</u>	<u>22</u>

WELL LOCATION:
sec 27 T 2 R 10
3 1/2 miles E of WHITES CROSSING
(distance) (direction) (nearest town)

WELL PURPOSE: HOME
(home, irrigation, municipal, industrial)

WELL COMPLETION DATA:

(1) diameter (inches) 2"

(2) total depth (feet) 22"

(3) static water level (feet) 0 below above top of ground.

(4) casing PVC, 17',
(material) (depth)
(size) If telescope see back.

(5) screen 5', 17'
(length) (depth to top)
2", PVC
(size) (material)

(6) pump 1/2, 10
(HP) (yield gpm)
Elect.
(type power)

(7) electric log NO.
(yes or no)
(organization running log)

(8) how well bottom plugged B.W.V.


DECEMBER 1980
AUG 18 1980

Department of Natural Resources
Bureau of Land & Water Resources

DRILLERS REMARKS:

If well telescopes please sketch and show depths.

GROUND LEVEL

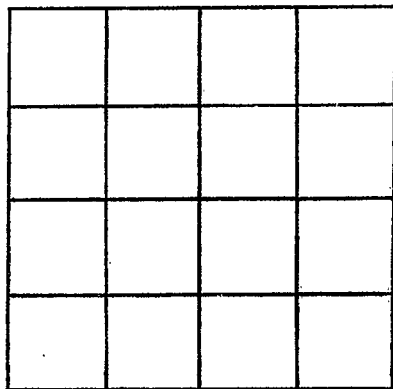

SECTION _____

Please indicate well location X.

ADDITIONAL INFORMATION

If more than one screen,
show locations of each on sketch.