

MISSISSIPPI DEPARTMENT OF NATURAL RESOURCES

Bureau of Land and Water Resources

Southport Mall

P.O. Box 10631

Jackson, Mississippi 39209

WATER WELL DRILLERS LOG

STONE
H 2045

5-30
date well completed

19 86' Frank Price
firm name

Stone
county well located

LANDOWNER:
J.E. Hooker
(mailing address)

description of formations encountered	from	to
Top Soil	0	2
Clay	2	10
Course Sand	10	30

WELL LOCATION:
sec 20 T. 3 S R. 9 E
1 miles N of Springs
(distance) (direction) (nearest town)

WELL PURPOSE:
(home, irrigation, municipal, industrial)

- WELL COMPLETION DATA:
- (1) diameter (inches) 2"
 - (2) total depth (feet) 30'
 - (3) static water level (feet) 10' below top of ground.
 - (4) casing PVC, 25' (material) (depth)
(size) If telescope see back.
 - (5) screen 25' (length) (depth to top)
(size) PVC (material)
 - (6) pump 1 (HP) 8 (yield gpm)
elect. (type power)
 - (7) electric log No. (yes or no)
(organization running log)
 - (8) how well bottom plugged B.W.V.


RECEIVED
AUG 18 1986

Department of Natural Resources
Bureau of Land & Water

DRILLERS REMARKS:

If well telescopes please
sketch and show depths.

GROUND LEVEL

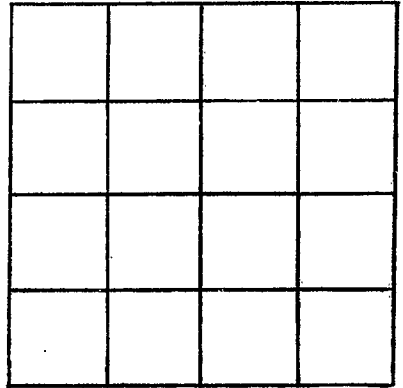

SECTION _____

Please indicate well location X.

ADDITIONAL INFORMATION

If more than one screen,
show locations of each on sketch.