

# MISSISSIPPI DEPARTMENT OF ENVIRONMENTAL QUALITY

Office of Land and Water Resources

P. O. Box 10631  
Jackson, MS 39289-0631  
**WATER WELL DRILLERS LOG**

*STONE Co.*

COUNTY WELL LOCATED <del>ADAMS</del>	
WELL NUMBER <b>H-2070</b>	CODED
DATE WELL COMPLETED <b>9-16-00</b>	

PERMIT NUMBER
NAME OF DRILLING FIRM <i>Coast Water Well Service</i>

NAME & MAILING ADDRESS OF LANDOWNER <b>Mike Foto</b>			
Well Location: <b>Perkinston, Ms.</b>			
WELL LOCATION	SEC <b>9</b>	TOWNSHIP <b>3</b>	RANGE <b>9<sup>N</sup> 9<sup>W</sup></b>
DISTANCE <b>2</b>	DIRECTION <b>NE</b>	NEAREST TOWN <b>Ramsey Springs</b>	
OTHER LANDMARK			
WELL PURPOSE: Home, Irrigation, Municipal, Industrial, Fish Pond, etc. <b>Camp</b>			

<b>PUMP DATA</b>		
PUMP TYPE (Circle One): Submersible, Turbine, <b>Jet</b> , Flowing Well, Other (Describe)		
POWER TYPE (Circle One): <b>Electric</b> , Tractor, Diesel, Gasoline, Butane, Other (Describe) <b>H/P</b>		
Pump Capacity (GPM) <b>8.5</b>	No of Stages <b>2</b>	Setting Depth <b>FT.</b>
PUMP TEST Well yielded _____ GPM with a drawdown of _____ ft. after _____ hours of pumping		

<b>WELL DATA</b>		
Well Depth <b>630'</b>	Casing Diameter (in) <b>2"</b>	Casing Length (ft) <b>615'</b>
Type of Casing <b>PVC</b>	Hole Depth <b>630'</b>	Depth to Static Water Level <b>30'</b>
TYPE OF COMPLETION: (Circle One or More): <b>Natural Development</b> , Underreamed, Telescoped, Open Hole, Other (Describe)		

<b>LOG DATA</b>	
TYPE OF LOG RUN (Circle One): Electric, Gamma Ray, Density, Sonic, Neutron, Other (Describe) <b>No Log Run</b>	
Name of Organization Running Log	

WELL GROUTED TO A DEPTH OF <b>20</b> FEET Type Grout (circle one): Cement, <b>Bentonite</b> , or Mix
---

<b>GEOLOGIC DATA (Office Use Only)</b>			
Surface Elev	Geologic Unit	Unit Thickness	Depth to Top
Subs. SWL	Date	Analysis	Aquifer Test
Driller's Remarks			
Top of Lap Pipe or Reduction in Casing <b>FEET</b> IF TELESCOPED OR MORE THAN ONE SCREEN, USE BACK PAGE			


<b>SCREEN DATA</b>		
Diameter - Inches <b>2"</b>	Length - Feet <b>15'</b>	Slot Size - Inches <b>.008</b>
Screen Type <b>PVC</b>	Depth to Bottom, Feet <b>630'</b>	

DESCRIPTION OF FORMATIONS ENCOUNTERED	FROM	TO
<b>Top Soil</b>	<b>0</b>	<b>2</b>
<b>Brown Clay</b>	<b>2</b>	<b>35</b>
<b>White Coarse Sand</b>	<b>35</b>	<b>50</b>
<b>Gray Clay-Str. Sand</b>	<b>50</b>	<b>552</b>
<b>Fine Sand</b>	<b>552</b>	<b>588</b>
<b>Coarse Sand</b>	<b>588</b>	<b>630</b>

ADDITIONAL INFORMATION (Continued) <b>12/11/01</b>	FROM	TO
<b>JAN 03 2001</b>		
Mississippi Department of Environmental Quality Office of Land and Water Resources		
IF MORE SPACE IS NEEDED, USE BACK		

If well telescopes please sketch and show depths.

GROUND LEVEL

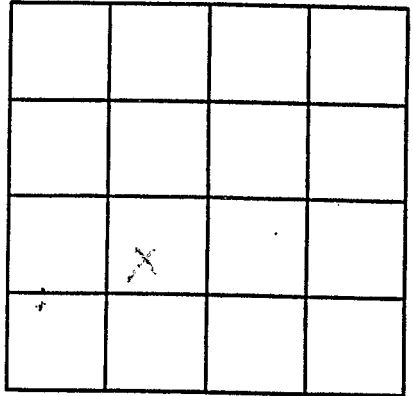

SECTION 7

Please indicate well location X.

ADDITIONAL INFORMATION

Lined area for additional information.

If more than one screen,