

3 STONE

J1  
S-62

WATER WELL DRILLERS LOG


Date: May, 19 62 Driller: Joe Miller County: Stone  
(Name)

(1) Owner of Land:	Description & Color of Materials Sand, Clay, Red Clay, Shell, etc.	Thick- ness Feet	Depth Feet
<u>U.S. Government</u> (Name) <u>Hickman Tower</u> (Address)	<u>Surface</u>	<u>8</u>	<u>8</u>
(2) Location: <u>SW 1/4, NE 1/4, Sec. 2 T. R.</u>	<u>Red sand</u>	<u>37</u>	<u>45</u>
<u>15</u> miles <u>south west</u> of <u>Wiggins</u> (distance) (direction) (Nearest Town)	<u>Bright sand (course)</u>	<u>57</u>	<u>102</u>
(3) Topography: <u>Hilly</u> (Hilly) (Flat) (Level)	<u>Ball Truckers Sand</u>	<u>3</u>	<u>105</u>
(4) Purpose of Well: <u>Domestic</u> (Domestic Irrigation Municipal, Industrial, Other)			

Information upon completion of well:

- (1) Diameter 2 inches.
- (2) Total Depth 103' feet.
- (3) Water Level \_\_\_\_\_ feet below top of ground.
- (4) Cased to 997', Size 2"
- (5) Screen: Size 2", Length 6'
- (6) Were any formations sealed against pollution?  
 yes, \_\_\_\_\_ no.

If YES depth of formation 10'  
Why Orders by Ranger  
Drillers Remarks:

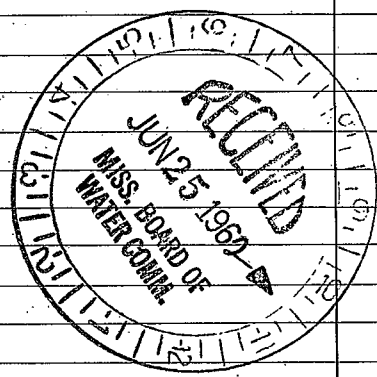

(Use Back Side)

Well No.

US RR 49

Melbury

well

the house

Happy Lake

Parking Road

