

STONE MISSISSIPPI BOARD OF WATER COMMISSIONERS

J3

8-24-62

WATER WELL DRILLERS LOG

Date: 8-24, 1962, Driller: Sutter Well Works County Stone  
 (Name)

(1) Owner of Land: James Beeson  
 (Name)

RFD - Perkinston, Miss.  
 (Address)

(2) Location: SE 1/4, NW 1/4, Sec. 4 T4R13, D

12 miles W, of McHenry  
 (distance) (direction) (Nearest Town)

(3) Topography: hilly  
 (Hilly) (Flat) (Level)

(4) Purpose of Well: domestic  
 (Domestic Irrigation  
 Municipal, Industrial, Other)

Description & Color of Materials.  
 Sand, Clay, Red Clay, Shell, etc.

Thick-  
 ness  
 Feet

Depth  
 Feet

Clay 85 85

Sand 7 92

Blue clay 128 220

Sand 56 276

Information upon completion of well:

(1) Diameter 4 inches.

(2) Total Depth 276 feet.

(3) Water Level 127 feet below top of ground.

(4) Cased to ace, Size 4"


(5) Screens: Size 4", Length 10'

(6) Were any formations sealed against pollution?  
 \_\_\_\_\_ yes,  no.

If YES, depth of formation \_\_\_\_\_

Why \_\_\_\_\_

Drillers Remarks: \_\_\_\_\_

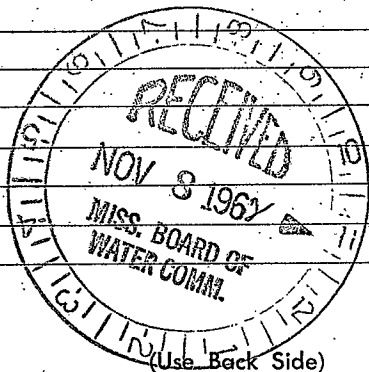

Well No.

Faint, illegible text, possibly bleed-through from the reverse side of the page. The text is arranged in several paragraphs and is mostly obscured by noise and low contrast.