

Stone  
J.5  
4-28-70

MISSISSIPPI  
BOARD OF WATER COMMISSIONERS  
416 North State Street  
Jackson, Mississippi 39201

WATER WELL DRILLERS LOG

April 28 1970 S+S Well Works Stone  
date well completed firm name county well located

LANDOWNER: Soren Ladner  
Rt. Perkins  
Miss.  
(mailing address)

description of formations encountered	depth	
	from	to
<u>top soil</u>	<u>0</u>	<u>2</u>
<u>clay</u>	<u>2</u>	<u>20</u>
<u>sand</u>	<u>20</u>	<u>30</u>
<u>gravel</u>	<u>30</u>	<u>50</u>

WELL LOCATION:  
sec. 29 T 4 N R 13 E  
18 miles N of Hull  
(distance) (direction) (nearest town)

WELL PURPOSE: home  
(home, irrigation, municipal, industrial)


- WELL COMPLETION DATA:
- diameter (inches) 2 1/2
  - total depth (feet) 50
  - static water level (feet) 35 below above top of ground.
  - casing P.V.C., 145,  
(material) (depth)  
(size) if telescope see back.
  - screen 5 ft., 11.5 ft.  
(length) (depth to top)  
2 in., P.V.C.  
(size) (material)
  - pump 1 5  
(HP) (yield gpm)  
E  
(type power)
  - electric log no  
(yes or no)  
(organization running log)
  - how well bottom plugged B.W.

DRILLERS REMARKS:  
none

MAY 13 1970  
MISS. SD. OF  
WATER COMMISSIONERS

If well telescopes please sketch and show depths.

GROUND LEVEL

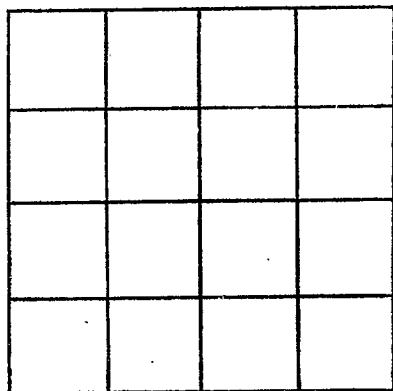

SECTION \_\_\_\_\_

Please indicate well location X.

ADDITIONAL INFORMATION

If more than one screen,  
show locations of each on sketch.