

**MISSISSIPPI
BOARD OF WATER COMMISSIONERS**
416 North State Street
Jackson, Mississippi 39201

CODED

WATER WELL DRILLERS LOG

STONE
J 9
6-18-73

6/18 1973
date well completed

COASTAL DRILLING & SERVICE CO.
ROUTE 1 BOX 818
Biloxi, Miss.
firm name

Stone
county well located

LANDOWNER:

Frank Maniscalco

Rt 1 Box 138 B

(mailing address)

WELL LOCATION:

sec. 33 T. 3 N. R. 9 E.
S. W.

1/2 miles NE of Home Refuge
(distance) (direction) (nearest town)

WELL PURPOSE:

home
(home, irrigation, municipal, industrial)

WELL COMPLETION DATA:

- (1) diameter (inches) 2"
- (2) total depth (feet) 345'
- (3) static water level (feet) 34' below above top of ground.
- (4) casing flow 335'
(material) (depth)
- if telescope see back.
(size)
- (5) screen 10' 335'
(length) (depth to top)
- 2" S.S.
(size) (material)
- (6) pump one 17
(HP) (yield gpm)
- 3/4
(type power)
- (7) electric log no
(yes or no)

(organization running log)

(8) how well bottom plugged

2" hard work valve

DRILLERS REMARKS:

none

description of formations encountered

	from	to
<i>top soil</i>	<i>1</i>	<i>3</i>
<i>Red Sand</i>	<i>3</i>	<i>15</i>
<i>white Sand</i>	<i>15</i>	<i>25</i>
<i>Soft Blue Clay</i>	<i>25</i>	<i>200</i>
<i>Hard Blue Clay</i>	<i>200</i>	<i>230</i>
<i>fine water sand</i>	<i>230</i>	<i>240</i>
<i>Hard Blue Clay</i>	<i>240</i>	<i>285</i>
<i>fine water sand</i>	<i>285</i>	<i>305</i>
<i>coarse water sand</i>	<i>305</i>	<i>345</i>

CODED


Jan. 31, 1974

SEP 7 1973

MADE BY DE
WATER BOARD
STATE OF MISSISSIPPI

If well telescopes please sketch and show depths.

GROUND LEVEL

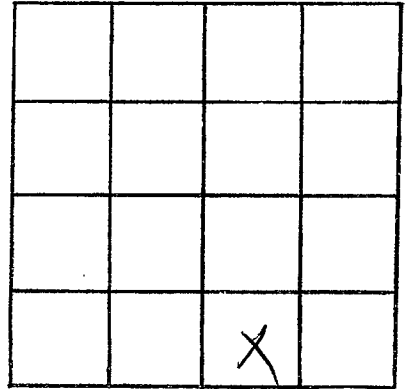

SECTION _____

Please indicate well location X.

ADDITIONAL INFORMATION

If more than one screen,
show locations of each on sketch.