

STONE  
J 11  
9/23/74

MISSISSIPPI  
BOARD OF WATER COMMISSIONERS  
416 North State Street  
Jackson, Mississippi 39201

CODED

WATER WELL DRILLERS LOG

9-23 date well completed  
1974 Pamela Anderson firm name  
Stone county well located

LANDOWNER:  
James H Laddner  
(mailing address)

description of fomations encountered	from	to
Top Soil	0	3
White Clay	3	28
Blue Clay	28	90
Coarse Sand	90	105

WELL LOCATION:  
sec. 22 T 4 S R 13 E  
miles of (distance) (direction) (nearest town)

WELL PURPOSE: HOME  
(home, irrigation, municipal, industrial)

WELL COMPLETION DATA:

(1) diameter (inches) 2"

(2) total depth (feet) 105'

(3) static water level (feet) 28' below top of ground

(4) casing Plastic, 100' (material) (depth)  
(size) if telescope see back.

(5) screen 5' / 100' (length) (depth to top)  
2" Plastic (size) (material)

(6) pump 1 / 10 (HP) (yield gpm)  
Elect (type power)

(7) electric log NO (yes or no)  
(organization running log)

(8) how well bottom plugged Back wash valve

CODED


RECEIVED  
OCT 10 1974

DRILLERS REMARKS:

MISS. BD. OF WATER COM.

If well telescopes please sketch and show depths.

GROUND LEVEL

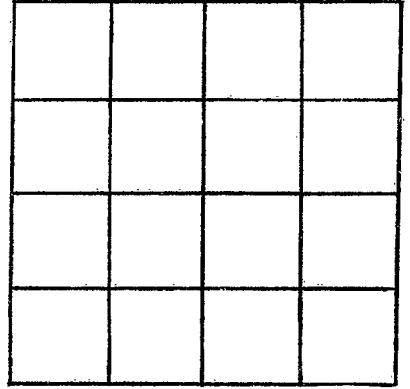

SECTION \_\_\_\_\_

Please indicate well location X.

ADDITIONAL INFORMATION

If more than one screen, show locations of each on sketch.