

Stone
 J12
 8-18-75

MISSISSIPPI
 BOARD OF WATER COMMISSIONERS
 416 North State Street
 Jackson, Mississippi 39201

CODED

WATER WELL DRILLERS LOG

8-18 1975 Parnell Anderson Stone
 date well completed firm name county well located

LANDOWNER:	description of formations encountered	from	to
David Brooks	Top Soil	0	4
(mailing address)	1/2" of clay	4	21
	Coarse Sand	21	43'

WELL LOCATION:
 sec. 33 T 4 N R 13 E 135
 S W of Perk
 12 miles (distance) SW (direction) of (nearest town)

CODED

WELL PURPOSE: HOME
 (home, irrigation, municipal, industrial)


- WELL COMPLETION DATA:
- (1) diameter (inches) 2"
 - (2) total depth (feet) 43'
 - (3) static water level (feet) 16' below top of ground.
 - (4) casing Plastic 38'
 (material) (depth)
 (size) If telescope see back.
 - (5) screen 5" 38'
 (length) (depth to top)
2" Plastic
 (size) (material)
 - (6) pump 1/2 5
 (HP) (yield gpm)
Electric
 (type power)
 - (7) electric log No
 (yes or no)
- (organization running log)
- (8) how well bottom plugged Drugged

DRILLERS REMARKS:

RECEIVED
 SEP - 1 1975

If well telescopes please sketch and show depths.

GROUND LEVEL

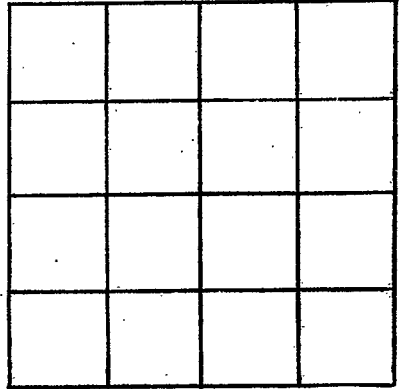

SECTION _____

Please indicate well location X.

ADDITIONAL INFORMATION

If more than one screen, show locations of each on sketch.