

Stone  
 J 2000  
 6-21-77

MISSISSIPPI  
 BOARD OF WATER COMMISSIONERS  
 416 North State Street  
 136 Jackson, Mississippi 39201

WATER WELL DRILLERS LOG

6-21-1977 *Parrell Anderson Stone*  
 date well completed firm name county well located


LANDOWNER:	description of formations encountered	from	to
<i>Charles Barber</i>			
(mailing address)	<i>Course Sand</i>	<i>2</i>	<i>38</i>
WELL LOCATION:	<i>White Clay</i>	<i>38</i>	<i>77</i>
sec. <i>30</i> T <i>4</i> N R <i>13</i> E S W	<i>Fin Sand</i>	<i>77</i>	<i>85</i>
<i>15</i> miles <i>SW</i> of <i>Duck</i> (distance) (direction) (nearest town)	<i>Clay</i>	<i>85</i>	<i>127</i>
WELL PURPOSE: <i>HOME</i> (home, irrigation, municipal, industrial)	<i>Fin Sand</i>	<i>127</i>	<i>176</i>
WELL COMPLETION DATA:	<i>Course Sand</i>	<i>176</i>	<i>185</i>
(1) diameter (inches) <i>2"</i>			
(2) total depth (feet) <i>185'</i>			
(3) static water level (feet) <i>90'</i> below top of ground.			
(4) casing <i>Plastic, 190'</i> (material) (depth)			
(size) If telescope see back.			
(5) screen <i>5', 180'</i> (length) (depth to top)			
<i>2", Plastic</i> (size) (material)			
(6) pump <i>1</i> <i>6</i> (HP) (yield gpm)			
<i>Elect</i> (type power)			
(7) electric log <i>No</i> (yes or no)			
(organization running log)			
(8) how well bottom plugged <i>Capped</i>			
DRILLERS REMARKS:			

RECEIVED

MAR 5 - 1977

If well telescopes please sketch and show depths.

GROUND LEVEL

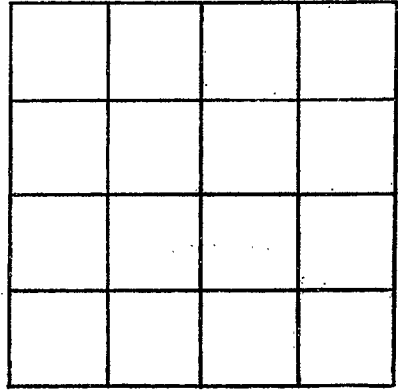

SECTION \_\_\_\_\_

Please indicate well location X.

ADDITIONAL INFORMATION

If more than one screen, show locations of each on sketch.