

STONE
J 2001
12-06-78

**MISSISSIPPI
BOARD OF WATER COMMISSIONERS**
416 North State Street
Jackson, Mississippi 39201

WATER WELL DRILLERS LOG

12-6 1978 Donnell Anderson Stone
 date well completed firm name county well located

LANDOWNER:	description of formations encountered	from	to
<u>Mamie Ladner</u>	<u>Top Soil</u>	<u>0</u>	<u>3</u>
(mailing address)	<u>Clay</u>	<u>3</u>	<u>12</u>
WELL LOCATION:	<u>Course Street</u>	<u>12</u>	<u>50</u>
sec <u>29 T 4 N R 13 E</u>			
<u>11</u> miles <u>W</u> of <u>M Henry</u>			
(distance) (direction) (nearest town)			
WELL PURPOSE: <u>HOME</u>			
(home, irrigation, municipal, industrial)			
WELL COMPLETION DATA:			
(1) diameter (inches) <u>2"</u>			
(2) total depth (feet) <u>50'</u>			
(3) static water level (feet) <u>40'</u> below top of ground.			
(4) casing <u>Plastic</u> , <u>45'</u>			
(material) (depth)			
(size) If telescope see back.			
(5) screen <u>5'</u> , <u>45'</u>			
(length) (depth to top)			
<u>2"</u> , <u>Plastic</u>			
(size) (material)			
(6) pump <u>1</u> , <u>10</u>			
(HP) (yield gpm)			
<u>Elect</u>			
(type power)			
(7) electric log <u>no</u>			
(yes or no)			
(organization running log)			
(8) how well bottom plugged <u>Capped</u>			

RECEIVED


JAN 8 1978

DRILLERS REMARKS:

MISS. BD. OF WATER COMMISSIONERS

If well telescopes please sketch and show depths.

GROUND LEVEL

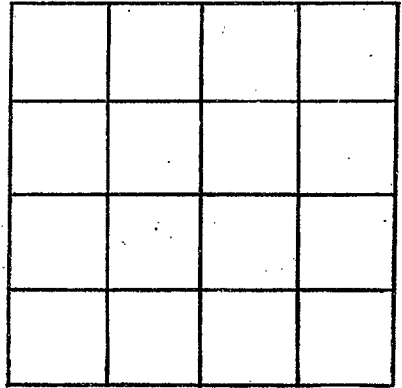

SECTION _____

Please indicate well location X.

ADDITIONAL INFORMATION

If more than one screen,
show locations of each on sketch.