

STONE
 J 2002
 2-28-79

MISSISSIPPI
 BOARD OF WATER COMMISSIONERS
 416 North State Street
 Jackson, Mississippi 39201

WATER WELL DRILLERS LOG

2-28 1979 Samuel Rudeman Stone
 date well completed firm name county well located

LANDOWNER:
Pat Roberts
 (mailing address)

WELL LOCATION:
 sec. 17 T 4 N R. 13 E
 S W
71 miles W of McKenna
 (distance) (direction) (nearest town)

WELL PURPOSE: HOME
 (home, irrigation, municipal, industrial)

WELL COMPLETION DATA:

(1) diameter (inches) 2"

(2) total depth (feet) 143'

(3) static water level (feet) 81 below top of ground.

(4) casing Plastic 138'
 (material) (depth)
 (size) if telescope see back.

(5) screen 5" 138'
 (length) (depth to top)
2" Plastic
 (size) (material)

(6) pump 1 6
 (HP) (yield gpm)
Elect
 (type power)

(7) electric log NO
 (yes or no)
 (organization running log)

(8) how well bottom plugged
Capped

description of formations encountered	from	to
<u>Topsoil</u>	<u>0</u>	<u>2</u>
<u>Sand</u>	<u>2</u>	<u>40</u>
<u>Clay</u>	<u>40</u>	<u>68</u>
<u>Course Sand</u>	<u>68</u>	<u>92</u>
<u>Clay</u>	<u>92</u>	<u>96</u>
<u>Fine Sand</u>	<u>96</u>	<u>120</u>
<u>Clay</u>	<u>120</u>	<u>124</u>
<u>Course Sand</u>	<u>124</u>	<u>143</u>

Miss. Board of Water Comm.


MAR 5 1979

RECEIVED

DRILLERS REMARKS:

If well telescopes please sketch and show depths.

GROUND LEVEL

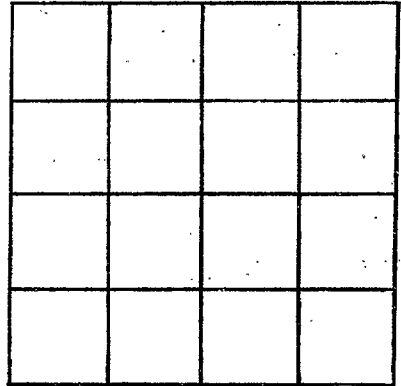

SECTION _____

Please indicate well location X.

ADDITIONAL INFORMATION

If more than one screen, show locations of each on sketch.