

STONE  
J 2003  
1-29-80

MISSISSIPPI  
BOARD OF WATER COMMISSIONERS  
416 North State Street  
Jackson, Mississippi 39201

WATER WELL DRILLERS LOG

CODED  
Stone


1-29-80 date well completed 50 Parnell Anderson firm name Stone county well located

LANDOWNER:	description of formations encountered	from	to
John Nicholes	Top Soil	0	2
(mailing address)	Clay	2	70
WELL LOCATION:	Fire Sand	70	82
sec. 7 T 4 N R 13 E S W	Lake		
2 miles W of Red Hen (distance) (direction) (nearest town)			
WELL PURPOSE: HOME (home, irrigation, municipal, industrial)			
WELL COMPLETION DATA:			
(1) diameter (inches) 2"			
(2) total depth (feet) 82'			
(3) static water level (feet) 55' below top of ground.			
(4) casing Plastic 77' (material) (depth)			
(size) If telescope see back.			
(5) screen 5' 77' (length) (depth to top)			
2" Plastic (size) (material)			
(6) pump 1 8 (HP) (yield gpm)			
Elect (type power)			
(7) electric log No (yes or no)			
(organization running log)			
(8) how well bottom plugged Capped			
DRILLERS REMARKS:			

DEPT. OF NATURAL RESOURCES  
BUREAU OF LAND & WATER RESOURCES  
FEB 11 1980  
RECEIVED

If well telescopes please sketch and show depths.

GROUND LEVEL

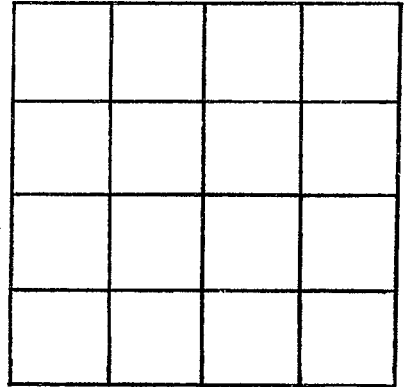

SECTION \_\_\_\_\_

Please indicate well location X.

ADDITIONAL INFORMATION

If more than one screen,  
show locations of each on sketch.