


STONE  
 J 2004  
 11-19-80

MISSISSIPPI  
 BOARD OF WATER COMMISSIONERS  
 416 North State Street  
 Jackson, Mississippi 39201

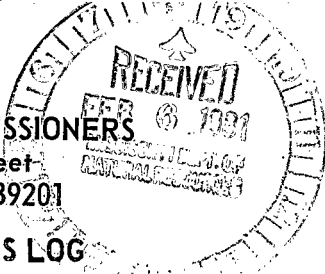


WATER WELL DRILLERS LOG

11-19-80 date well completed  
 BRADEN PUMP AND WELL SERVICE, INC. firm name  
 Stone county well located

LANDOWNER: <u>Ethana Davis</u>	description of formations encountered	from	to
<u>RT 2 Box 208-B</u> <u>Perkinston, MS</u> (mailing address)			
<b>WELL LOCATION:</b> sec. <u>9</u> T. <u>4</u> N. R. <u>13</u> E <u>9 3/4</u> miles <u>W</u> of <u>McHenry</u> (distance) (direction) (nearest town)	Clay	0	20
<b>WELL PURPOSE:</b> <u>home</u> (home, irrigation, municipal, industrial)	Sand	20	30
<b>WELL COMPLETION DATA:</b>	Clay	30	125
(1) diameter (inches) <u>2"</u>	Sand	125	135
(2) total depth (feet) <u>400'</u>	Clay	135	155
(3) static water level (feet) <u>95</u> below top of ground.	Sand	155	165
(4) casing <u>PVC</u> (material), <u>total</u> (depth)	Clay	165	175
<u>2"</u> (size) if telescope see back.	Sand	175	250
(5) screen <u>10'</u> (length), <u>385'</u> (depth to top)	Clay	250	297
<u>2"</u> (size), <u>PC underbar</u> (material)	Sand	297	320
(6) pump <u>1 1/2</u> (HP), <u>5</u> (yield gpm)	Clay	320	335
<u>230</u> (type power)	Sand	335	340
(7) electric log <u>no</u> (yes or no)	Clay	340	355
(organization running log)	Sand	355	380
(8) how well bottom plugged, <u>2" sand shark</u>	Clay	380	400
<b>DRILLERS REMARKS:</b> <u>20' tail pipe</u>			

If well telescopes please sketch and show depths.

GROUND LEVEL

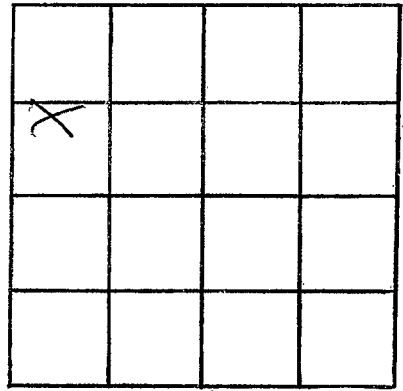

SECTION 9

Please indicate well location X.

ADDITIONAL INFORMATION

If more than one screen, show locations of each on sketch.