

MISSISSIPPI DEPARTMENT OF NATURAL RESOURCES

Bureau of Land and Water Resources

Southport Mall

P.O. Box 10631

Jackson, Mississippi 39209

WATER WELL DRILLERS LOG

Li #
0-432

Stone
J 2505
10-7-81

10-7 date well completed *Frank Price* firm name *Stone* county well located

LANDOWNER: <i>Soney Ladner</i>	description of formations encountered <i>Top Soil</i>	from	to
		0	3
(mailing address)	<i>Red Clay</i>	3	18

WELL LOCATION:
 sec. *32* T. *4* N. R. *13* E.
4 miles *S* of *Red Hawk Lake*
 (distance) (direction) (nearest town)

WELL PURPOSE:
 (home, irrigation, municipal, industrial)

WELL COMPLETION DATA:

(1) diameter (inches) *2"*

(2) total depth (feet) *74*

(3) static water level (feet) *55'* below top of ground.

(4) casing *Plastic, 69'*
 (material) (depth)

_____ if telescope see back.
 (size)

(5) screen *5'*, *69'*
 (length) (depth to top)

2", *Plastic*
 (size) (material)

(6) pump *1*, *6*
 (HP) (yield gpm)

Elect
 (type power)

(7) electric log *no*
 (yes or no)

_____ (organization running log)

(8) how well bottom plugged
Capred

DRILLERS REMARKS:


DEPT. OF NATURAL RESOURCES
 BUREAU OF LAND & WATER RESOURCES

NOV 3 - 1981

RECEIVED

If well telescopes please sketch and show depths.

GROUND LEVEL

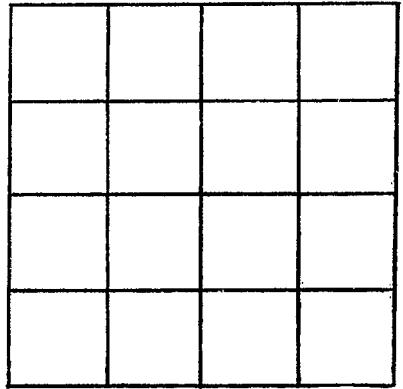

SECTION _____

Please indicate well location X.

ADDITIONAL INFORMATION

If more than one screen,
show locations of each on sketch.