

MISSISSIPPI DEPARTMENT OF NATURAL RESOURCES

Bureau of Land and Water Resources

Southport Mall

P.O. Box 10631

Jackson, Mississippi 39209

WATER WELL DRILLERS LOG

Stone
J 2000

1-5
date well completed

82 Frank Price
firm name

Stone
county well located

LANDOWNER:	description of formations encountered	from	to
Virgil Dedouff	Top Soil	0	3
(mailing address)	Clay	3	189
WELL LOCATION:	Lind Island	189	195
sec 20 T 4 S R 13 E W 2 miles S of Red Bay Lake	Course Land	195	208
WELL PURPOSE: HOME (home, irrigation, municipal, industrial)			
WELL COMPLETION DATA:			
(1) diameter (inches)			
(2) total depth (feet) 208			
(3) static water level (feet) 116 below top of ground.			
(4) casing Plastic, 203' (material) (depth)			
If telescope see back. (size)			
(5) screen 5' 203' (length) (depth to top)			
2" Plastic (size) (material)			
(6) pump 2 6 (HP) (yield gpm)			
Elect (type power)			
(7) electric log no (yes or no)			
(organization running log)			
(8) how well Bottom plugged Capped			
DRILLERS REMARKS:			


DEPT. OF NATURAL RESOURCES
BUREAU OF LAND & WATER RESOURCES

FEB - 8 1962

RECEIVED

If well telescopes please sketch and show depths.

GROUND LEVEL

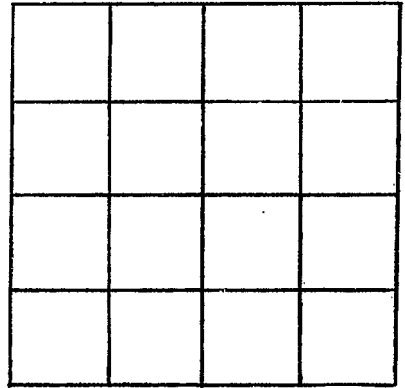

SECTION _____

Please indicate well location X.

ADDITIONAL INFORMATION

If more than one screen,
show locations of each on sketch.