

MISSISSIPPI DEPARTMENT OF NATURAL RESOURCES

Bureau of Land and Water Resources

Southport Mall

P.O. Box 10631

Jackson, Mississippi 39209

WATER WELL DRILLERS LOG

Stone
J 2007

6-15-19
date well completed

Frank P. Pico
firm name

Stone
county well located

LANDOWNER:	description of formations encountered	from	to
Ben Carpenters	Top Soil	0	2
(mailing address)	Blue Clay	2	140
WELL LOCATION:	Fin Sand	140	150
sec 26 T 4 N R 13 E S W Happy Lake	Blue Clay	150	222
(distance) miles (direction) of (nearest town)	Fin Sand	222	295
WELL PURPOSE: MUNICIPAL (home, irrigation, municipal, industrial)	Coarse Sand	295	260
WELL COMPLETION DATA:			
(1) diameter (inches) 4"			
(2) total depth (feet) 260'			
(3) static water level (feet) 80' below top of ground.			
(4) casing Plastic, 250' (material) (depth)			
(size) if telescope see back.			
(5) screen 10" length, 250' depth to top			
4" Plastic (size) (material)			
(6) pump 1 HP, 30 yield gpm			
Elect (type power)			
(7) electric log No (yes or no)			
(organization running log)			
(8) how well bottom plugged Back wash valve			
DRILLERS REMARKS:			


DEPT. OF NATURAL RESOURCES
BUREAU OF LAND & WATER RESOURCES

JUL - 8 1982

RECEIVED

If well telescopes please sketch and show depths.

GROUND LEVEL

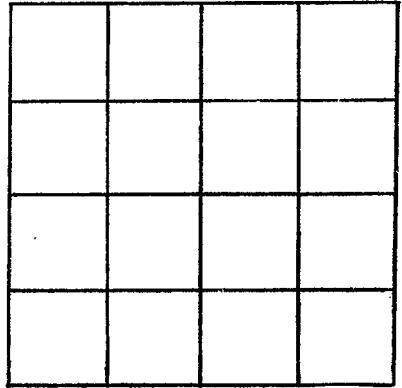

SECTION _____

Please indicate well location X.

ADDITIONAL INFORMATION

If more than one screen,
show locations of each on sketch.