

MISSISSIPPI DEPARTMENT OF NATURAL RESOURCES

Bureau of Land and Water Resources

Southport Mall

P.O. Box 10631

Jackson, Mississippi 39209

WATER WELL DRILLERS LOG

1520

8 2008

5-21 19*82* *Frank Pucci* *Ston*

date well completed firm name county well located

LANDOWNER:	description of formations encountered	from	to
<i>Ben Carpenters</i>	<i>Top Soil</i>	<i>0</i>	<i>2</i>
<i>Nappy Lake</i> (mailing address)	<i>Blue Clay</i>	<i>2</i>	<i>60</i>
	<i>Course Sand</i>	<i>60</i>	<i>73</i>

WELL LOCATION:

sec. *26* T *4* N R *13* E
S W

Nappy Lake
miles (distance) of (direction) (nearest town)

WELL PURPOSE: *MONTICPUL*
(home, irrigation, municipal, industrial)

WELL COMPLETION DATA:

(1) diameter (inches) *2*

(2) total depth (feet) *73'*

(3) static water level (feet) *42* below above top of ground.

(4) casing *Plastic, 68'*
(material) (depth)

_____ if telescope see back.
(size)

(5) screen *5' 68'*
(length) (depth to top)

2" *P. Plastic*
(size) (material)

(6) pump *01* *9*
(HP) (yield gpm)

Elect
(type power)

(7) electric log *no*
(yes or no)

_____ (organization running log)

(8) how well bottom plugged *Back west valve*



DRILLERS REMARKS:

DEPT. OF NATURAL RESOURCES
BUREAU OF LAND & WATER RESOURCES

JUN 15 1982

RECEIVED

If well telescopes please sketch and show depths.

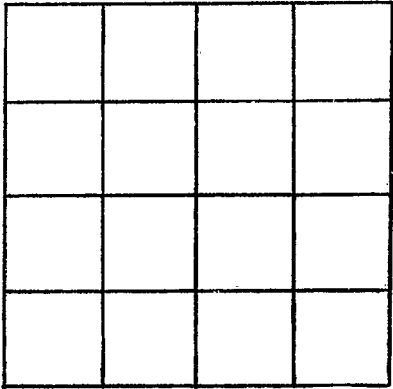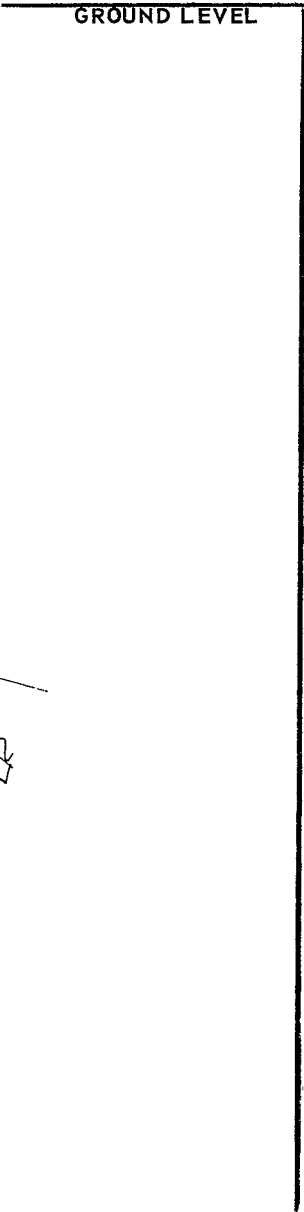

SECTION _____

Please indicate well location X.

ADDITIONAL INFORMATION

1/27

If more than one screen, show locations of each on sketch.
